


DATUM
 VERTICAL NGVD 1929
 HORIZONTAL NAD 1927

LEGEND	
	WORK ZONE
	TRAFFIC FLOW DIRECTION
	BARREL
	TYPE III BARRICADE
	SIGN LOCATION; TEMPORARY MOUNTING
	SIGN MOUNTED ON TYPE III BARRICADE
	FLAGGER LOCATION
	TRAFFIC CONE
	FLASHING ARROW BOARD

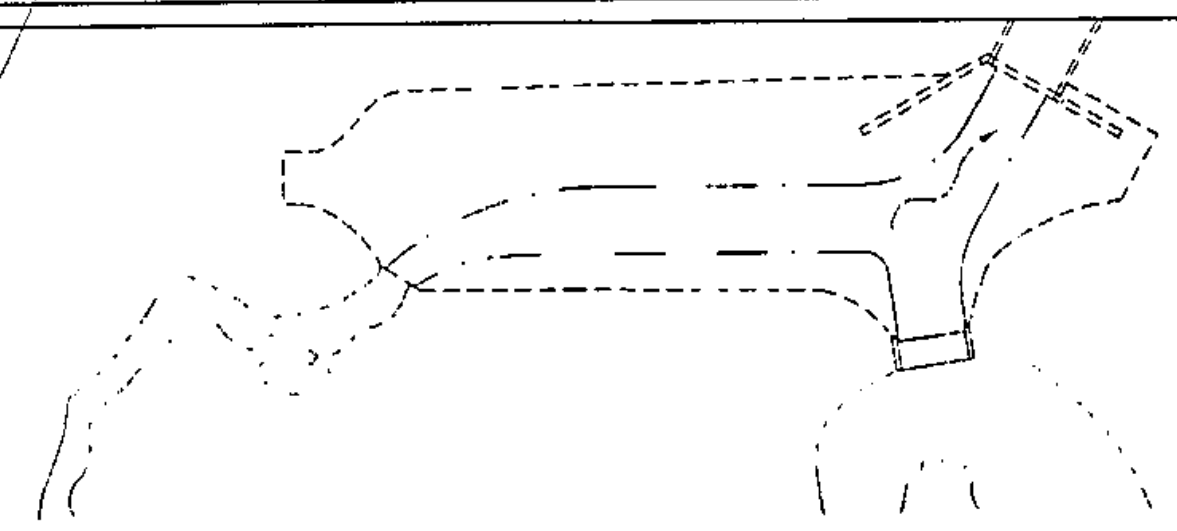

SCALE IN FEET
 0 40 80

4/13/04

PHASE 3
 SHELBURNE

SURVEYED BY: V.S.C. INC. DATE _____
 DRAWN BY: E.A.A. INC. DATE _____
 TRACED BY: E.A.A. INC. DATE _____

PROJECT NH-EGC-019-4(27)
 TRAFFIC CONTROL DRAWING NO. 17
 SHEET NO. 278 OF 537