


DATUM
 VERTICAL NGVD 1929
 HORIZONTAL NAD 1927

ITEM 641.15 - PORTABLE CHANGEABLE MESSAGE SIGN
 SHALL BE PLACED ON U.S. ROUTE 7 IN THE NORTHBOUND
 DIRECTION, AS PER THE ENGINEER.

4/13/04

LEGEND	
	WORK ZONE
	TRAFFIC FLOW DIRECTION
	BARREL
	TYPE III BARRICADE
	SIGN LOCATION; TEMPORARY MOUNTING
	SIGN MOUNTED ON TYPE III BARRICADE
	FLAGGER LOCATION
	TRAFFIC CONE
	FLASHING ARROW BOARD

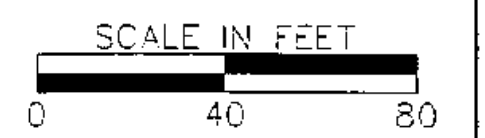

PHASE 3
 SHELBURNE

SURVEYED BY V.S.C. INC. DATE _____
 DRAWN BY E.A.A. INC. DATE _____
 TRACED BY E.A.A. INC. DATE _____

PROJECT NH-EGC-019-4(27)
 TRAFFIC CONTROL DRAWING NO. 20
 SHEET NO. 281 OF 537