


DATUM
 VERTICAL NCVD 1929
 HORIZONTAL NAD 1927

LEGEND	
	WORK ZONE
	TRAFFIC FLOW DIRECTION
	BARREL
	TYPE III BARRICADE
	SIGN LOCATION: TEMPORARY MOUNTING
	SIGN MOUNTED ON TYPE III BARRICADE
	FLAGGER LOCATION
	TRAFFIC CONE
	FLASHING ARROW BOARD

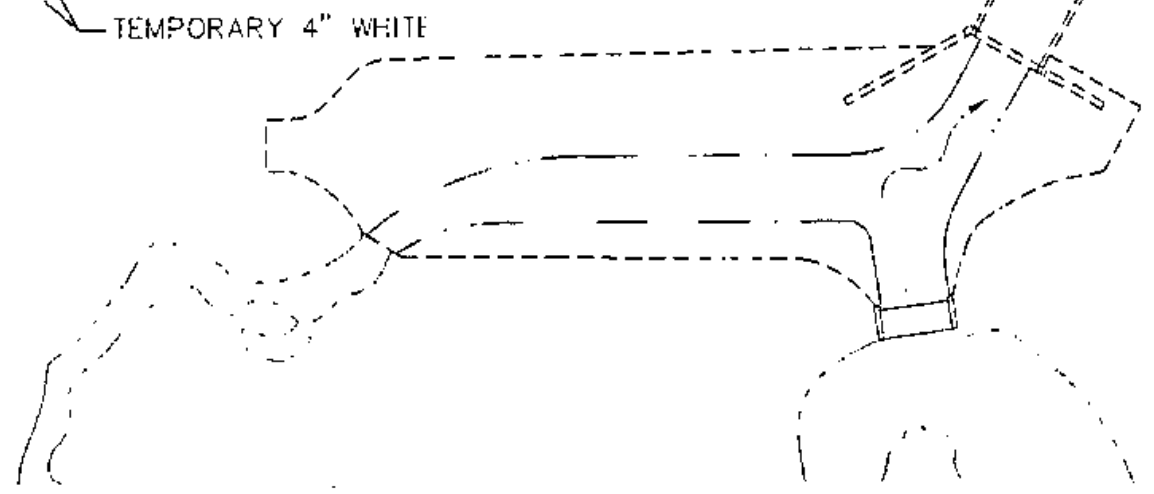

SCALE IN FEET
 0 40 80

4/13/04

PHASE 4
 SHELBURNE

SURVEYED BY V.S.C. INC. DATE _____
 DRAWN BY E.A.A. INC. DATE _____
 TRACED BY E.A.A. INC. DATE _____
 PROJECT NH-EGC-019-4(27)
 TRAFFIC CONTROL DRAWING NO. 23
 SHEET NO. 284 OF 537