



WEST SIDE TYPICAL

STREET TREE PLANTING SECTIONS - ROUTE 7
NOT TO SCALE


EAST SIDE TYPICAL

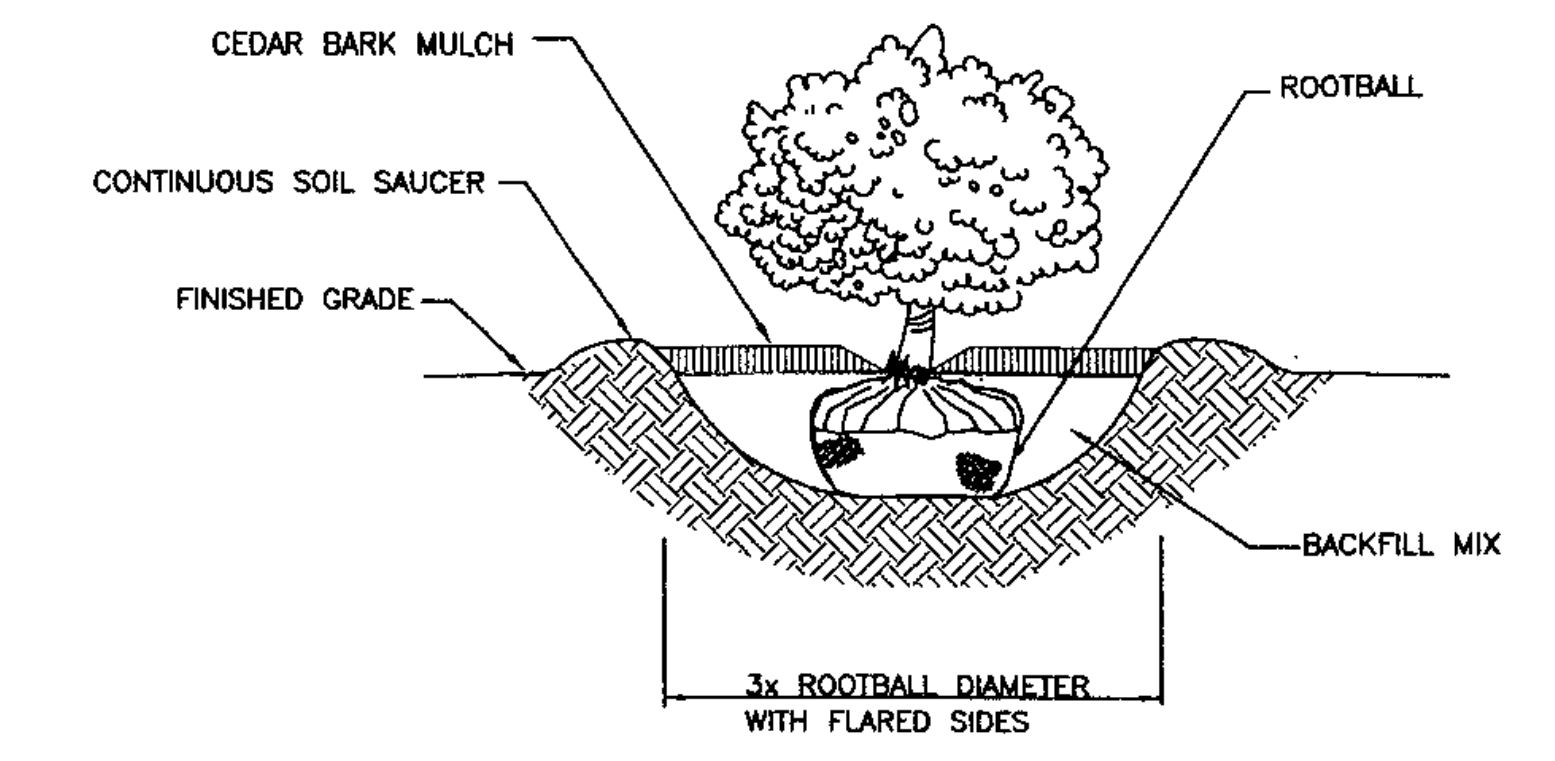


SHRUB PLANTING DETAIL
NOT TO SCALE

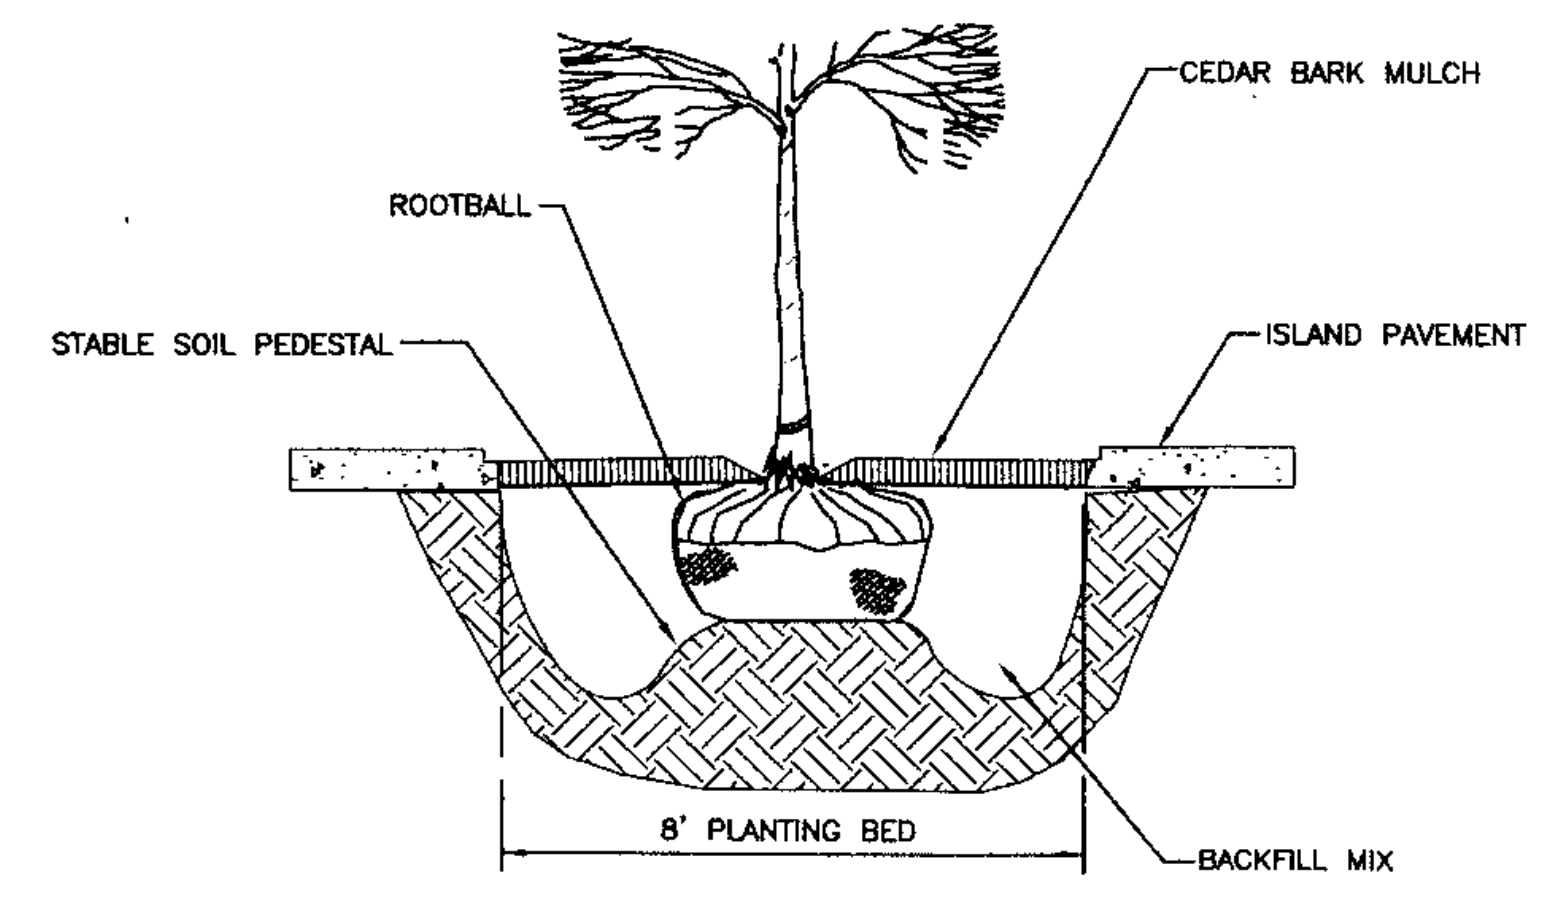


(STA 308+45, 329+40, 368+25)
TYPICAL PAVED MEDIAN PLANTING DETAIL
NOT TO SCALE

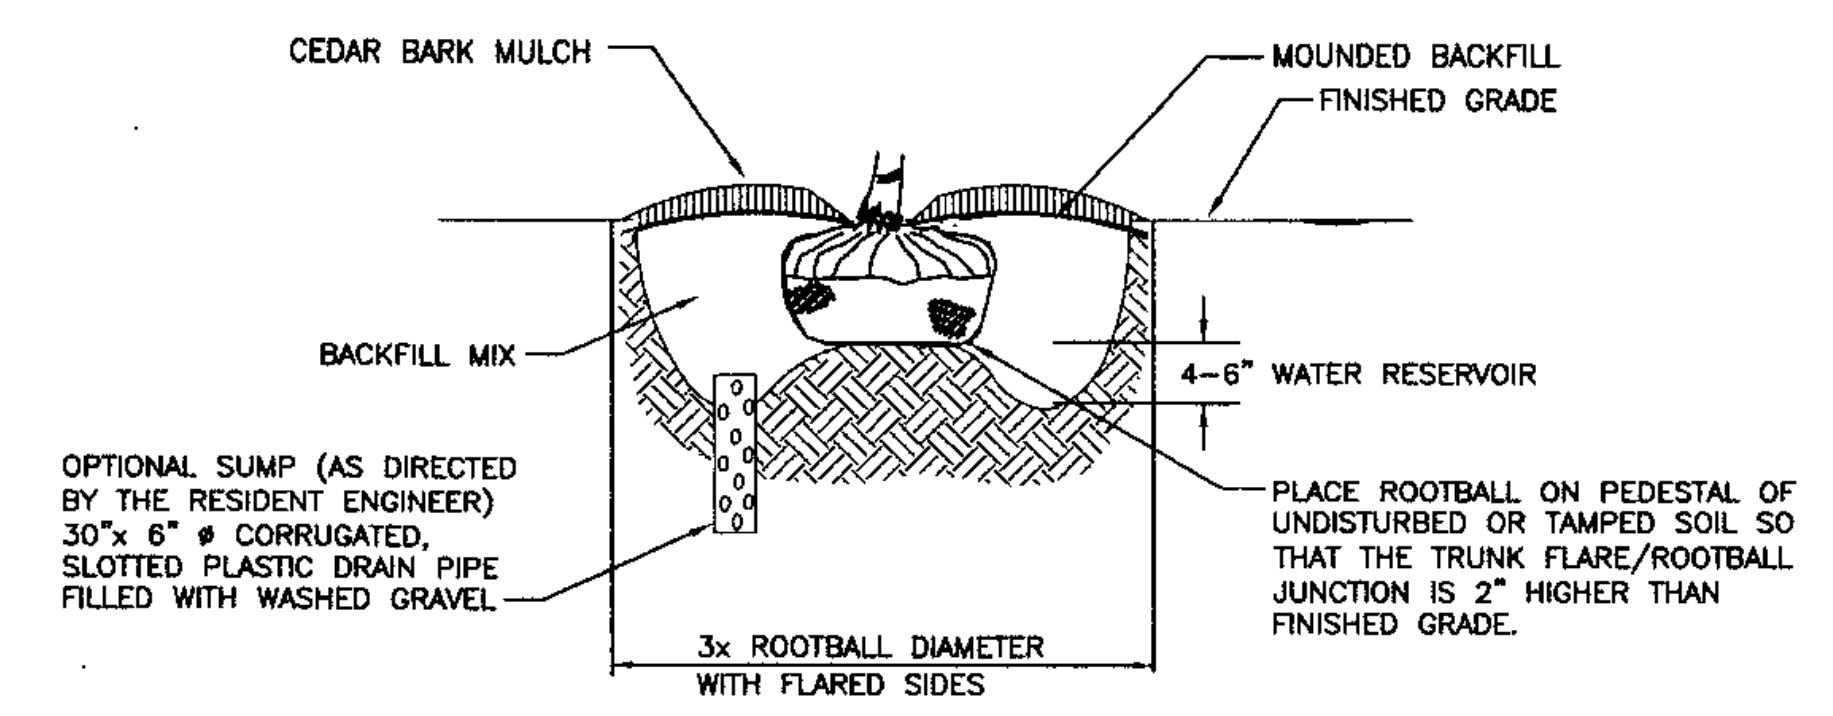


PLANTING DETAIL FOR TREES AND SHRUBS IN POORLY DRAINED SOIL
NOT TO SCALE

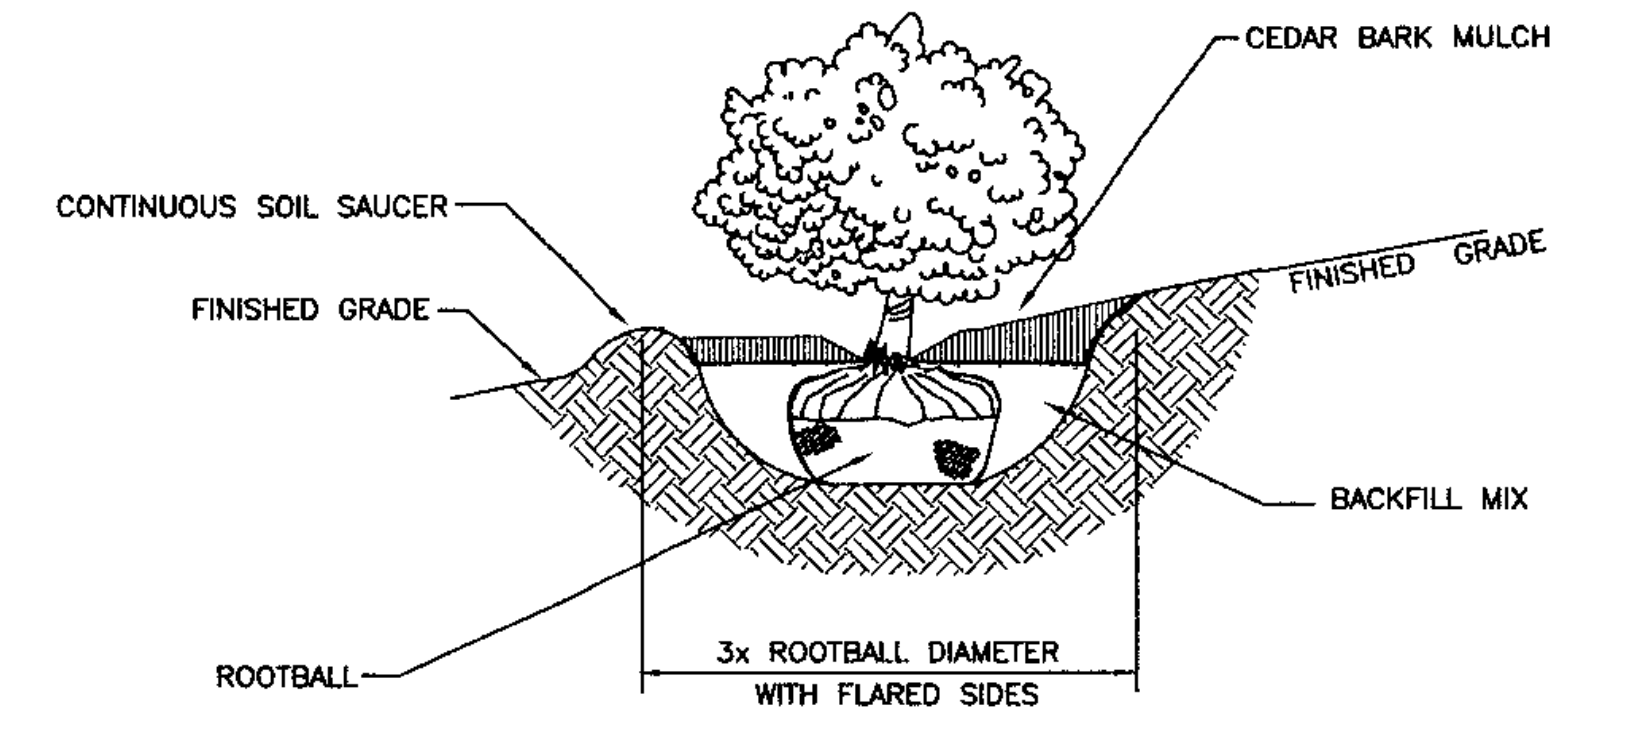


SHRUB PLANTING ON SLOPES DETAIL
NOT TO SCALE

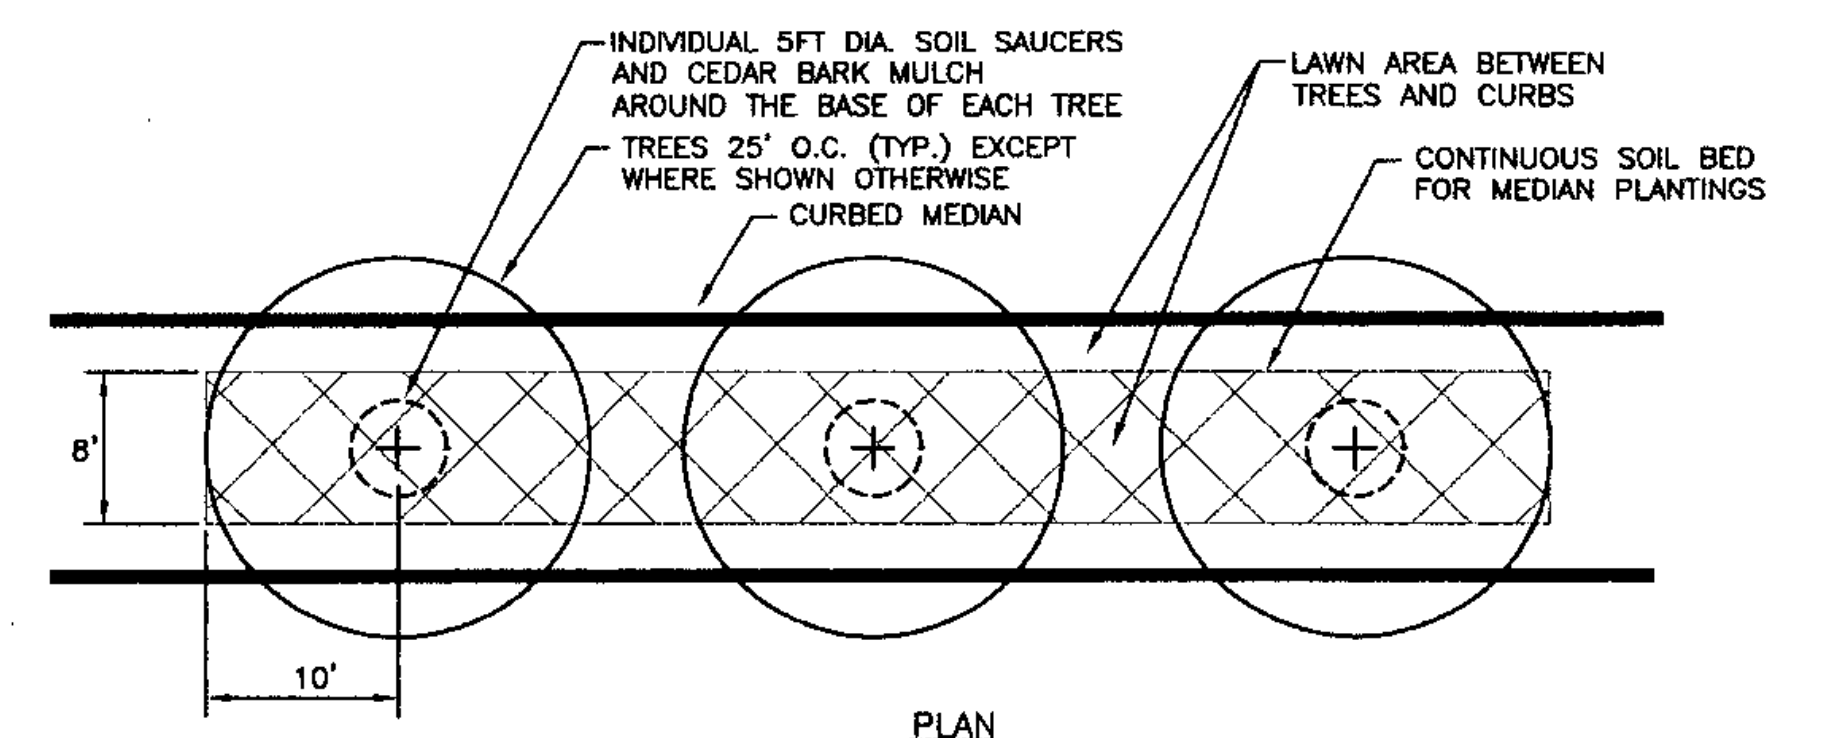

PLAN

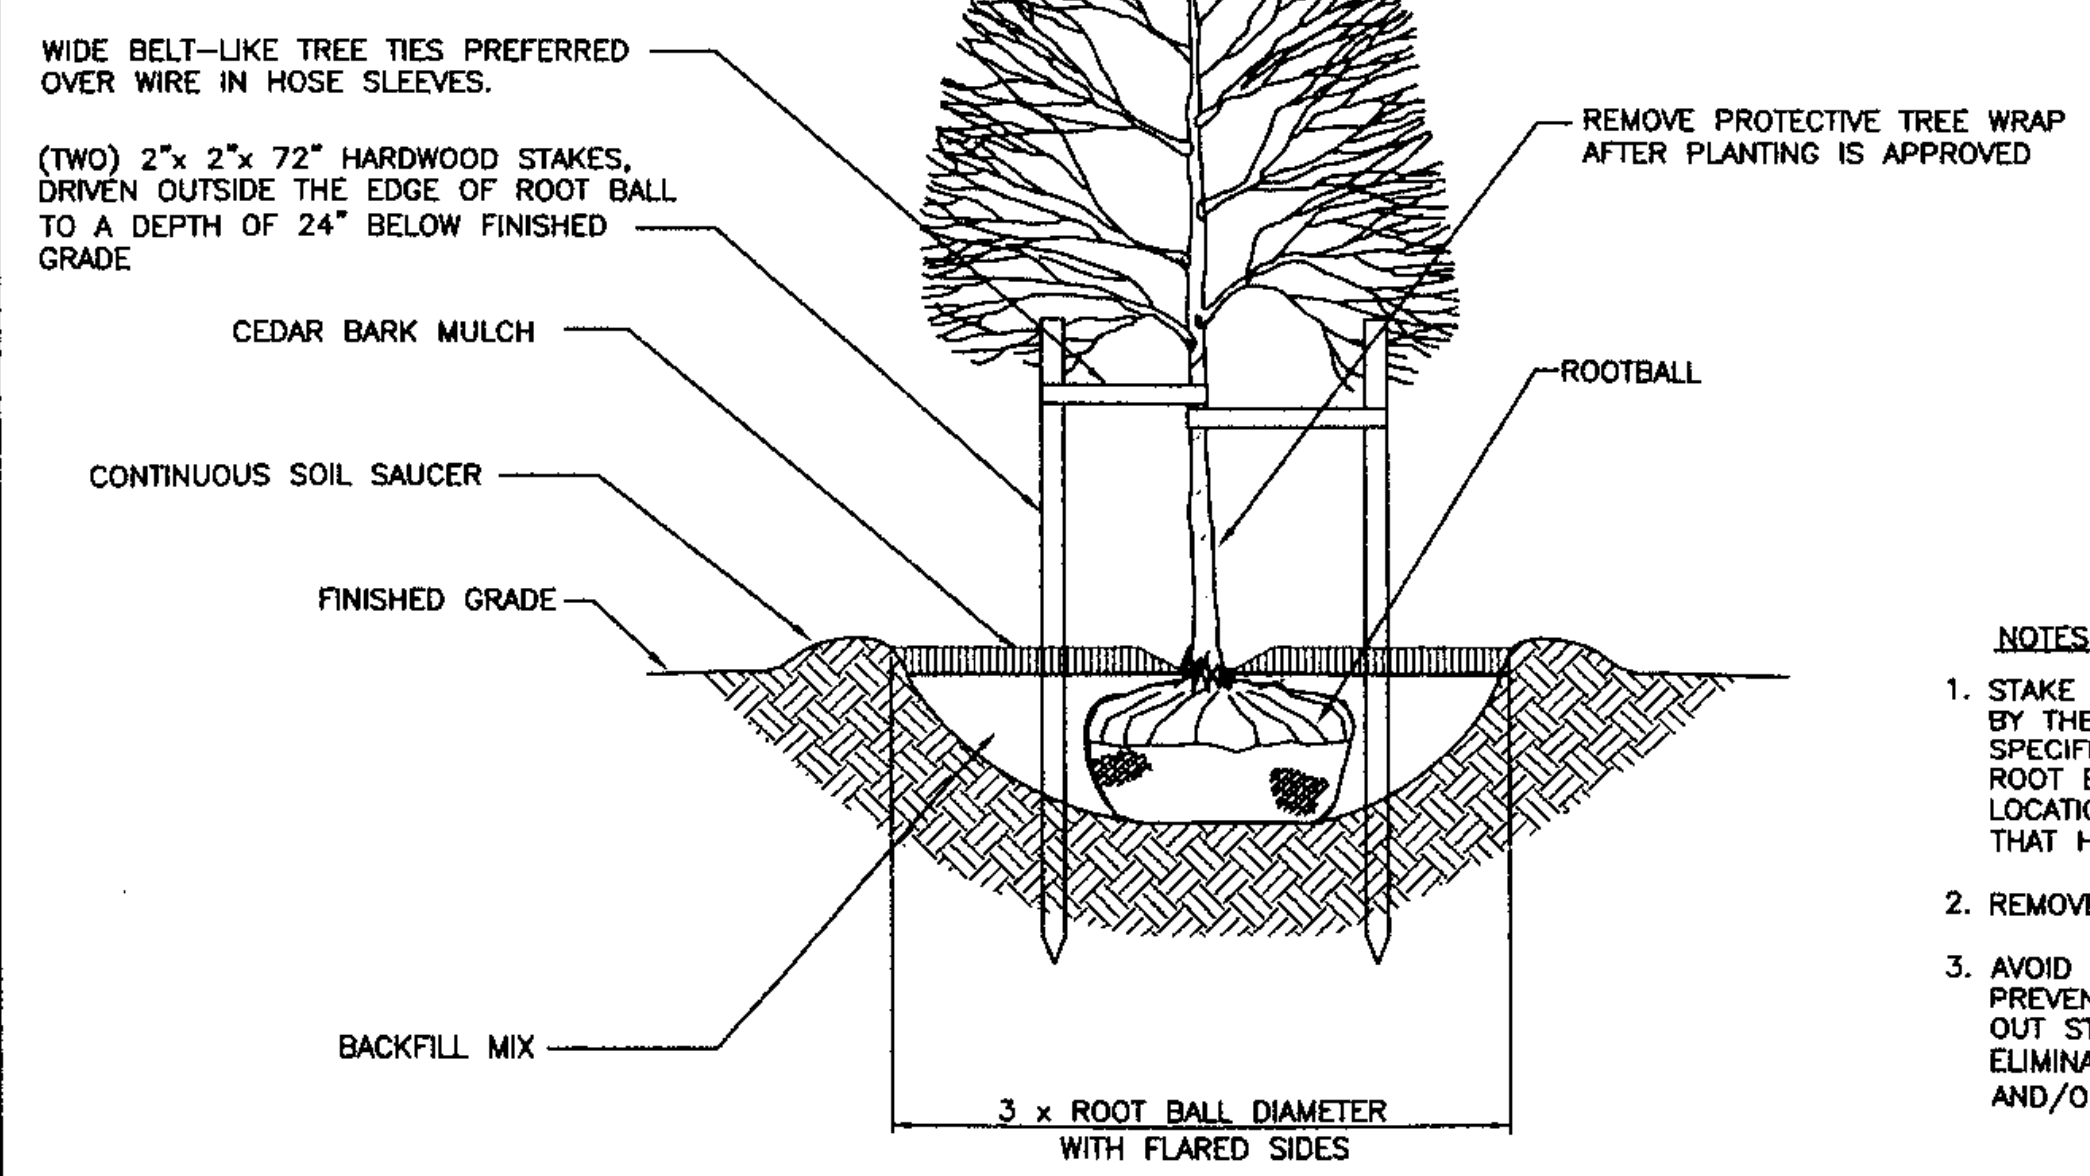


DECIDUOUS TREE PLANTING DETAIL
NOT TO SCALE

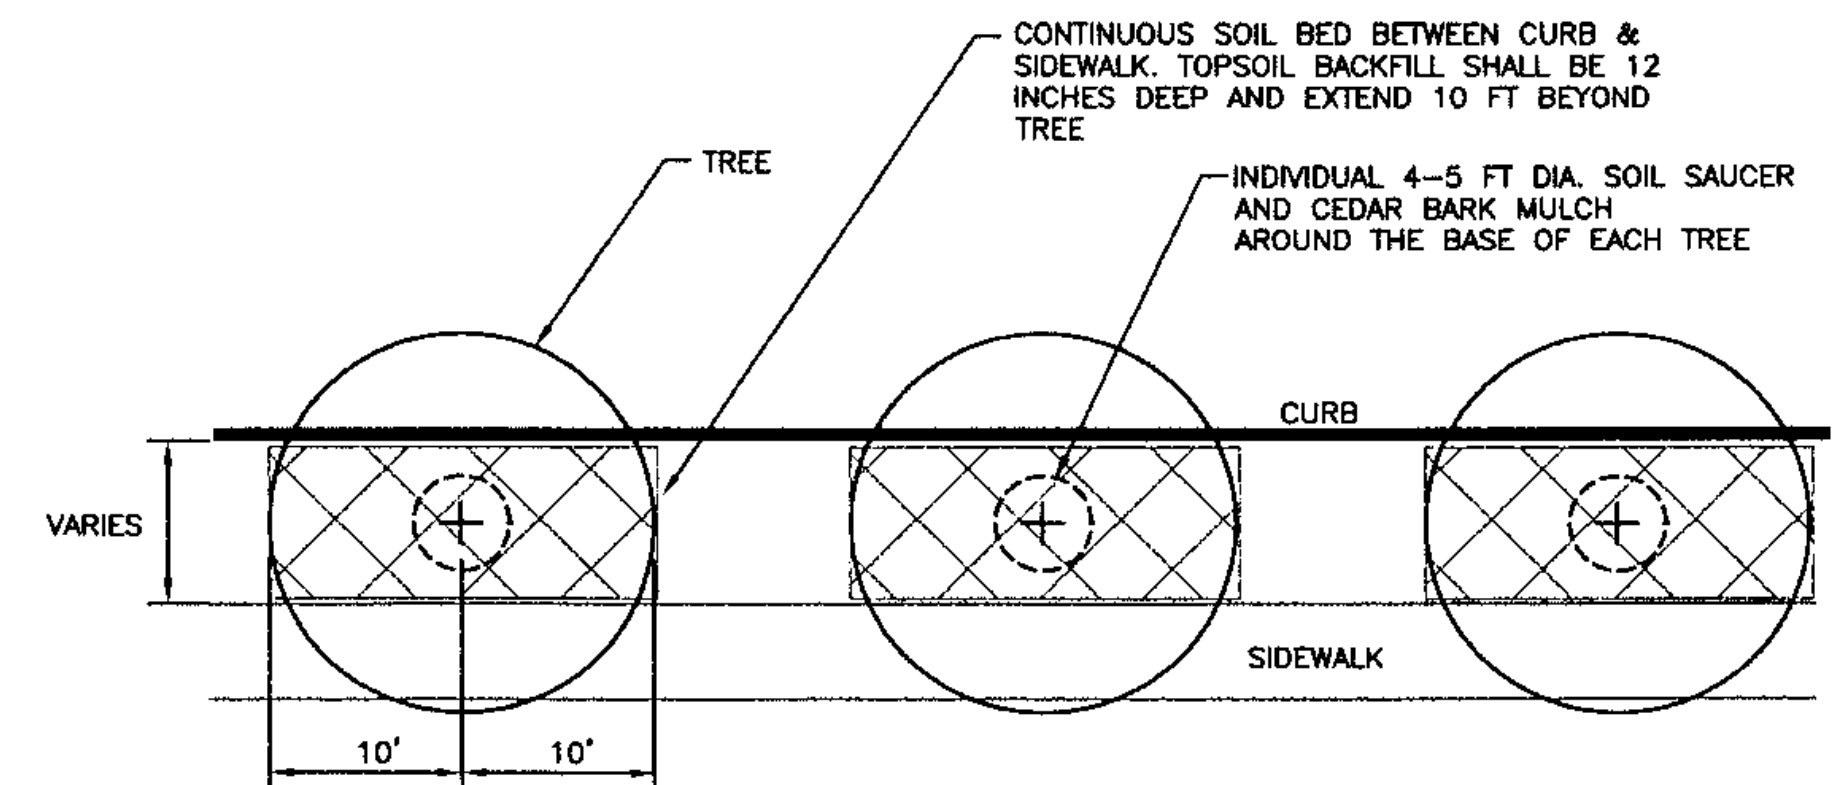

TYPICAL PLANTINGS BETWEEN CURB AND SIDEWALK DETAIL
NOT TO SCALE

- NOTES:
1. STAKE OR GUY TREES TO STABILIZE ROOT BALL WHEN DIRECTED BY THE RESIDENT ENGINEER, AND ONLY WHEN NECESSARY FOR SPECIFIC CONDITIONS INCLUDING SANDY SOILS IN EITHER THE ROOT BALL OR ADJACENT SOILS, OR IN EXTREMELY WINDY LOCATIONS. GUYS MAY NOT BE USED TO PULL TREES UPRIGHT THAT HAVE SETTLED OUT OF PLUMB.
 2. REMOVE GUYING MATERIAL AND STAKES ONE YEAR AFTER PLANTING.
 3. AVOID STOCKPILING BARK MULCH FOR LONG PERIODS OF TIME TO PREVENT ANAEROBIC CONDITIONS AND BUILD UP OF TOXINS. AIR OUT STOCKPILED BARK MULCH PRIOR TO ITS APPLICATION TO ELIMINATE ANY TOXIC FUMES THAT MAY DAMAGE PLANTS. DYED AND/OR SHREDDED WOOD MULCHES ARE NOT ACCEPTABLE.

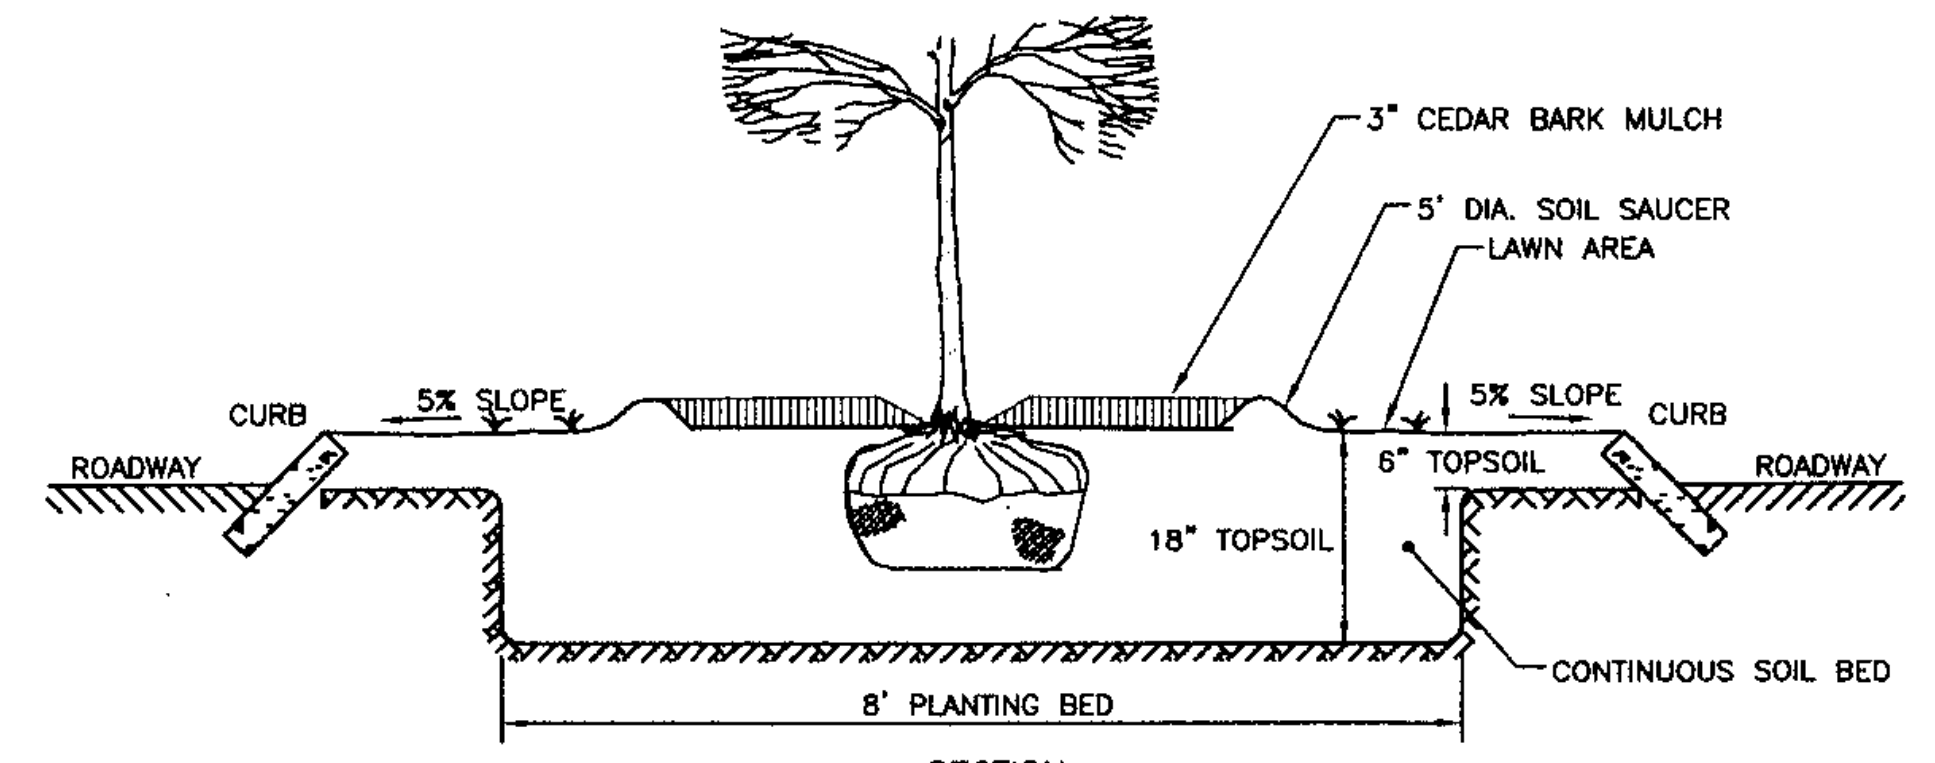

SECTION

TYPICAL TURF MEDIAN PLANTING DETAIL
NOT TO SCALE

<p>engineering planning management development</p>	<p>LANDSCAPE DETAILS</p>	<p>PROJECT: SHELburne/ SOUTH BURLINGTON ROUTE 7 IMPROVEMENTS</p>	<p>PROJECT NO. : NH EGC FECC-019-4(27)</p>
		<p>DESIGN FILE NAME: 118317F-02</p> <p>IPARM FILE NAME:</p> <p>SURVEYED BY:</p> <p>SQUAD LEADER: J. STEELE</p> <p>DWG NO. 2 OF 28</p>	<p>PLOT DATE: 4/28/04</p> <p>SURVEY DATE:</p> <p>DRAWN BY: K. KOLOSKI</p> <p>SHEET: 290 OF 537</p>