


MATCH TO SHEET 3 - STA 261+00

MATCH TO SHEET 5 - STA 267+00

LEGEND

- EXISTING TREELINE
- EXISTING EVERGREEN TREE
- EXISTING DECIDUOUS TREE
- TOE OF SLOPE
- TOP OF CUT
- TREE BED - SEE DETAIL SHEET 02
- PROPOSED DECIDUOUS TREE WITH PLANT TYPE AND PAY ITEM
- APPROX. LOCATION OF OVERHEAD POWERLINES
- STREET LIGHT

DATUM
 VERTICAL _____
 HORIZONTAL _____

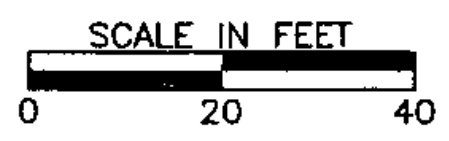

DuBois & King
 engineering planning management development

LANDSCAPE PLAN
 STA 261+00 TO 267+00

PROJECT: SHELBURNE/SOUTH BURLINGTON ROUTE 7 IMPROVEMENTS	PROJECT NO.: NH EGC FECC-019-4(27)
DESIGN FILE NAME: 118317F-04	PLOT DATE: 4/28/04
IPARM FILE NAME:	SURVEY DATE:
SURVEYED BY:	DRAWN BY: K. KOLOSKI
SQUAD LEADER:	SHEET 292 OF 537
DWG NO. 4 OF 28	