
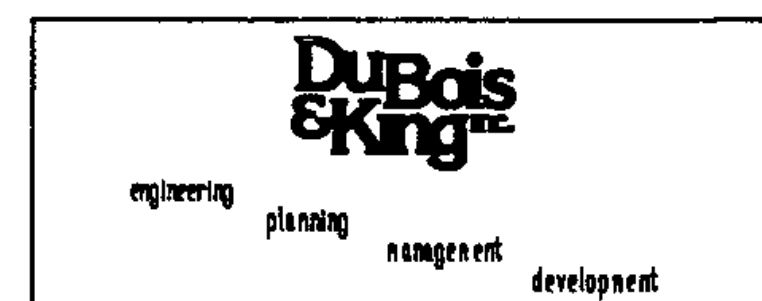


DATUM	
VERTICAL	_____
HORIZONTAL	_____

- LEGEND**
- EXISTING TREELINE
 - EXISTING EVERGREEN TREE
 - EXISTING DECIDUOUS TREE
 - TOE OF SLOPE
 - TOP OF CUT
 - TREE BED - SEE DETAIL SHEET 02
 - PROPOSED DECIDUOUS TREE WITH PLANT TYPE AND PAY ITEM
 - APPROX. LOCATION OF OVERHEAD POWERLINES
 - STREET LIGHT

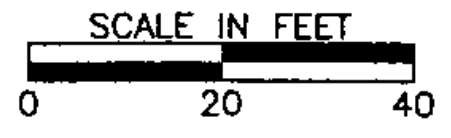

LANDSCAPE PLAN
STA 297+00 TO 303+00

PROJECT: SHELBURNE/SOUTH BURLINGTON ROUTE 7 IMPROVEMENTS	PROJECT NO. : NH EGC FECC-019-4(27)
DESIGN FILE NAME: 118317F-10	PLOT DATE: 4/28/04
IPARM FILE NAME:	SURVEY DATE:
SURVEYED BY:	DRAWN BY: K. KOLOSKI
SQUAD LEADER:	SHEET 298 OF 537
DWG NO. 10 OF 28	