


MATCH TO SHEET 14 - STA. 327+00

MATCH TO SHEET 16 - STA. 333+00

**LEGEND**

- EXISTING TREELINE
- EXISTING EVERGREEN TREE
- EXISTING DECIDUOUS TREE
- TOE OF SLOPE
- TOP OF CUT
- TREE BED - SEE DETAIL SHEET 02
- PROPOSED DECIDUOUS TREE WITH PLANT TYPE AND PAY ITEM
- APPROX. LOCATION OF OVERHEAD POWERLINES
- STREET LIGHT

DATUM  
 VERTICAL \_\_\_\_\_  
 HORIZONTAL \_\_\_\_\_

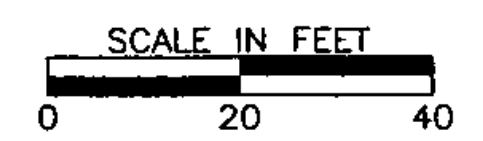

**DUBois & King**  
 engineering planning management development

**LANDSCAPE PLAN**  
 STA 327+00 TO 333+00

PROJECT: SHELburne/SOUTH BURLINGTON ROUTE 7 IMPROVEMENTS	PROJECT NO.: NH EGC FECC-019-4(27)
DESIGN FILE NAME: 11B317F-15	PLOT DATE: 4/28/04
IPARM FILE NAME:	SURVEY DATE:
SURVEYED BY:	DRAWN BY: K. KOLOSKI
SQUAD LEADER:	SHEET 303 OF 537
DWG NO. 15 OF 28	