

DATUM ELEV. = 160.00

DATUM ELEV. = 150.00

DATUM ELEV. = 140.00

STA. 261+50+33-LT  
24\"/>

GRADE ELEV. 172.57  
Sta. 261+50+14  
20\"/>


Sta. 261+50+22-RT  
Silt & Sand  
Silt & Sta. Moist.  
Pass. Layer  
ONPT

GRADE ELEV. 170.44  
0.042  
0.003

ADJUST T.G. 170.78  
Sta. 260+95+20-RT  
EXIST. DROP INLET  
T.G. 170.19  
INV. 163.50 IN 18\"/>

GRADE ELEV. 168.17  
0.042  
0.011  
0.004

EXIST. UNDERDRAIN TRENCH  
8\"/>

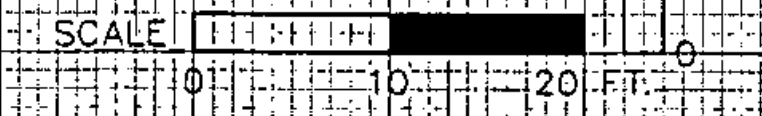

STA. 260+48 TO STA. 261+48  
 SURVEYED BY V.S.C. INC. DATE \_\_\_\_\_  
 DRAWN BY E.A.A. INC. DATE \_\_\_\_\_  
 TRACED BY E.A.A. INC. DATE \_\_\_\_\_  
 PROJECT NH-EGC-019-4(27)  
 CROSS-SECTION DWG. NO. 7  
 SHEET 320 OF 537

4/13/04

160 150 140 130 120 110 100 90 80 70 60 50 40 30 20 10 0 10 20 30 40 50 60 70 80 90 100 110 120