

DATUM ELEV. = 175.00


DATUM ELEV. = 175.00

DATUM ELEV. = 170.00

DATUM ELEV. = 170.00

STA. 262+97.26 LT.
 BUILD NEW 30" x 30" D.I.
 I.G. = 176.14
 INV. 170.64 18" OPTION PIPE E IN
 170.64 24" OPTION PIPE N IN
 170.14 24" OPTION PIPE S OUT

STA. 263+14.20 RT
 BUILD NEW TYPE R.C.D.I.
 I.G. = 178.78
 INV. 172.19 18" OPTION PIPE W OUT

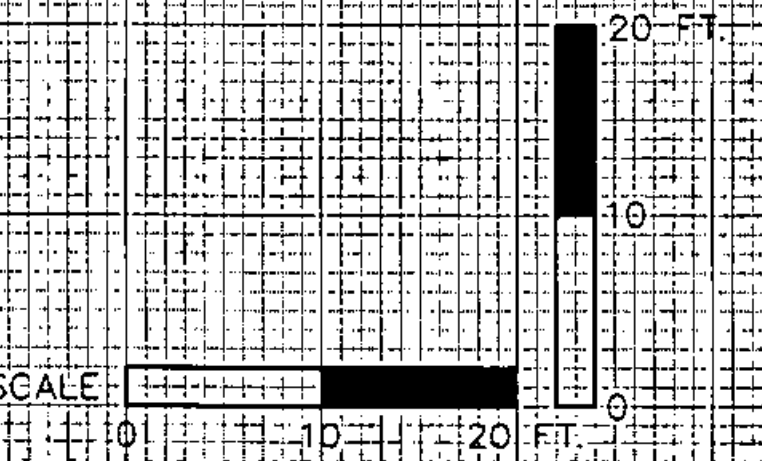

STA. 261+98 TO STA. 263+48
 SURVEYED BY V.S.C. INC. DATE _____
 DRAWN BY E.A.A. INC. DATE _____
 TRACED BY E.A.A. INC. DATE _____
 PROJECT NH-EGC-019-4(27)
 CROSS-SECTION DWG. NO. 8
 SHEET 321 OF 537

4/13/04