


STA. 265+47.65 LT.  
 STA. 26+50.22 LT. (JUGHANDLE A)  
 BUILD NEW 48" DIA. GB  
 T.G. 181.68  
 INV. 176.15 24" OPTION PIPE N IN  
 176.15 24" OPTION PIPE E OUT

STA. 264+97.28 LT.  
 NEW TYPE A D.I.  
 T.G. 181.49  
 INV. 175.84 24" OPTION PIPE N IN  
 175.84 24" OPTION PIPE S OUT

CONSTRUCT WEBSTER ROAD  
 STA. 265+47.51 = 10+00.00

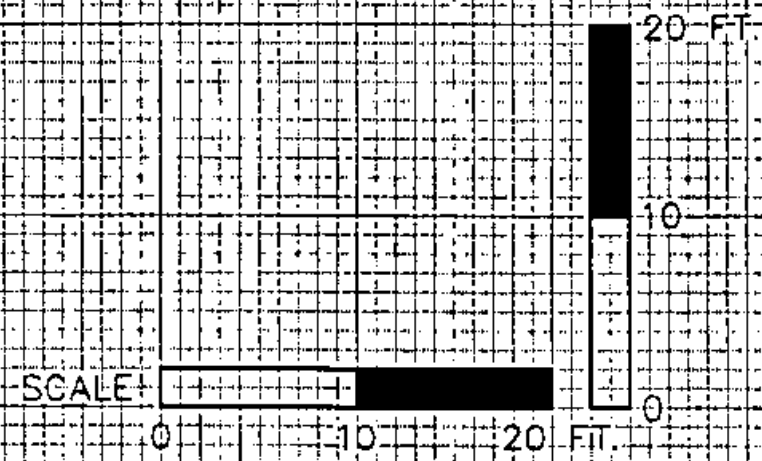

SHELBURNE  
 STA. 263+98 TO STA. 265+48  
 SURVEYED BY V.S.C. INC. DATE \_\_\_\_\_  
 DRAWN BY E.A.A. INC. DATE \_\_\_\_\_  
 TRACED BY E.A.A. INC. DATE \_\_\_\_\_  
 PROJECT NH-EGC-019-4(27)  
 CROSS-SECTION DWG. NO. 9  
 SHEET 322 OF 537

4/13/04