



EXISTING BLDG. #446
STA. 267+50 TO 268+27

STA. 267+97.56


STA. 267+47.55

STA. 267+40.55

DATUM ELEV. = 180.00

DATUM ELEV. = 180.00

DATUM ELEV. = 180.00

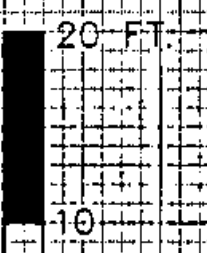

SHELBURNE
 STA. 267+41 TO STA. 267+98
 SURVEYED BY V.S.C. INC. DATE _____
 DRAWN BY E.A.A. INC. DATE _____
 TRACED BY E.A.A. INC. DATE _____
 PROJECT NH-EGC-019-4(27)
 CROSS-SECTION DWG. NO. 11
 SHEET 324 OF 537

4/13/04

160 150 140 130 120 110 100 90 80 70 60 50 40 30 20 10 0 10 20 30 40 50 60 70 80 90 100 110 120