

CONSTRUCT MAPLE LEAF LANE
STA. 301+57.50 = 190+00.00

DATUM ELEV. = 165.00

STA. 301+47.80

DATUM ELEV. = 165.00


STA. 300+97.80

DATUM ELEV. = 165.00

STA. 300+71.80

DATUM ELEV. = 165.00

STA. 300+55.80

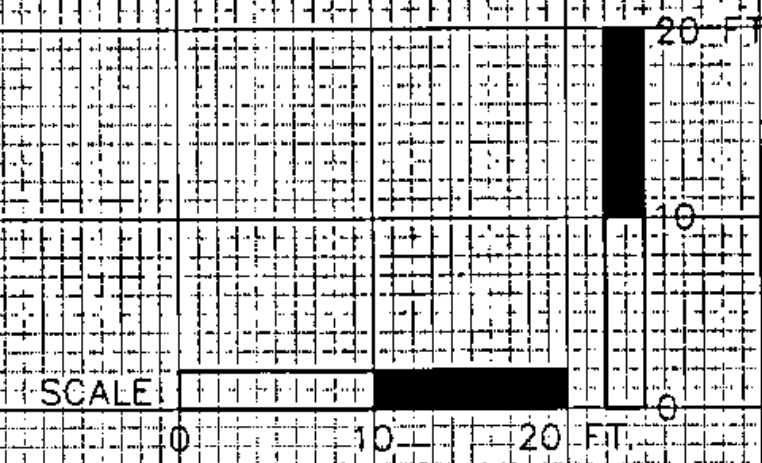

STA. 300+56 TO STA. 301+48
SURVEYED BY V.S.C. INC. DATE _____
DRAWN BY E.A.A. INC. DATE _____
TRACED BY E.A.A. INC. DATE _____
PROJECT NH-EGC-019-4(27)
CROSS-SECTION DWG. NO. 33
SHEET 346 OF 537

4/13/04

160 150 140 130 120 110 100 90 80 70 60 50 40 30 20 10 0 10 20 30 40 50 60 70 80 90 100 110 120

160'