

DATUM ELEV. = 160.00

DATUM ELEV. = 160.00

DATUM ELEV. = 160.00


DATUM ELEV. = 160.00

STA. 305+97.80

STA. 305+47.80

STA. 305+26.80

STA. 305+14.80

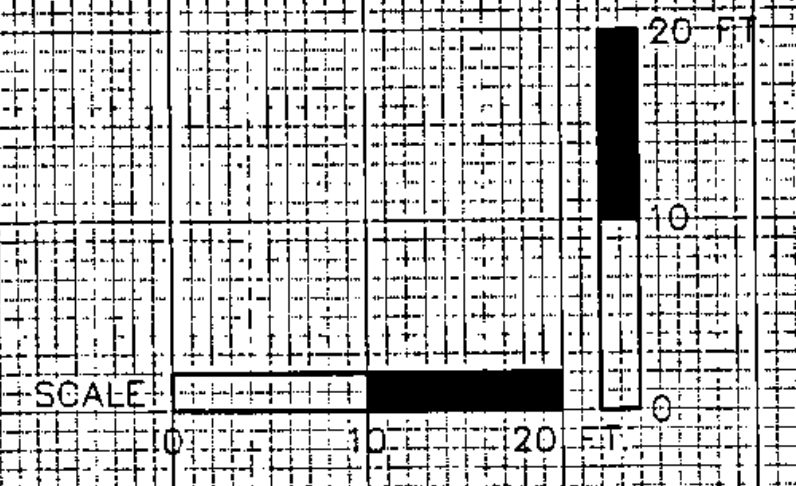

SHELburne

STA. 305+15 TO STA. 305+98  
 SURVEYED BY V.S.C. INC. DATE \_\_\_\_\_  
 DRAWN BY E.A.A. INC. DATE \_\_\_\_\_  
 TRACED BY E.A.A. INC. DATE \_\_\_\_\_  
 PROJECT NH-EGC-019-4(27)  
 CROSS-SECTION DWG. NO. 37  
 SHEET 350 OF 537

4/13/04

160 150 140 130 120 110 100 90 80 70 60 50 40 30 20 10 0 10 20 30 40 50 60 70 80 90 100 110 120

50