

DATUM ELEV. = 160.00

DATUM ELEV. = 160.00

DATUM ELEV. = 160.00

DATUM ELEV. = 160.00

STA. 307+41.80

STA. 306+97.80


STA. 306+63.80

STA. 306+47.80

EXISTING BLDG. #3725  
STA. 306+53 TO 307+02

EXISTING BLDG. #3725  
STA. 306+53 TO 307+02

STA. 306+49.37.5 R  
EXISTING STONE HEADWALL  
INV. 164.81 15" R.C.P.

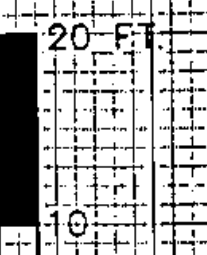

SHELburne

STA. 306+48 TO STA. 307+42

SURVEYED BY V.S.C. INC. DATE \_\_\_\_\_

DRAWN BY E.A.A. INC. DATE \_\_\_\_\_

TRACED BY E.A.A. INC. DATE \_\_\_\_\_

PROJECT NH-EGC-019-4(27)

CROSS-SECTION DWG. NO. 38

SHEET 351 OF 537

4/13/04

160 150 140 130 120 110 100 90 80 70 60 50 40 30 20 10 0 10 20 30 40 50 60 70 80 90 100 110 120