

DATUM ELEV. = 150.00

DATUM ELEV. = 155.00

DATUM ELEV. = 155.00

DATUM ELEV. = 155.00

STA. 312+97.80

STA. 312+50.80


STA. 312+47.80

STA. 311+97.80

STA. 312+25.17 LT.
 BUILD NEW 30" X 30" D.I.
 T.G. 159.63
 INV. 155.20 18" OPTION PIPE E. OUT

STA. 312+32.37 LT.
 BUILD NEW 48" DIA. C.B.
 T.G. 160.75
 INV. 153.72 18" OPTION PIPE W. IN.
 153.22 18" OPTION PIPE S. IN.
 153.22 18" OPTION PIPE N. OUT

STA. 312+27.40 RT.
 EXISTG. STONE HEADWALL
 INV. 154.41 15" C.M.P.

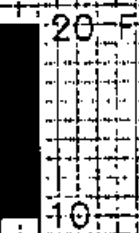

STA. 311+98 TO STA. 312+98
 SURVEYED BY V.S.C. INC. DATE _____
 DRAWN BY E.A.A. INC. DATE _____
 TRACED BY E.A.A. INC. DATE _____
 PROJECT NH-EGC-019-4(27)
 CROSS-SECTION DWG. NO. 42
 SHEET 355 OF 537

4/13/04

SHELburne

160 150 140 130 120 110 100 90 80 70 60 50 40 30 20 10 0 10 20 30 40 50 60 70 80 90 100 110 120