

DATUM ELEV = 140.00


DATUM ELEV = 145.00

DATUM ELEV = 150.00

DATUM ELEV = 150.00

STA. 316+11.37 LT  
 BUILD NEW 72" DIA. C.B.  
 T.C. 157.02  
 INV. 147.96 18" OPTION PIPE N IN  
 150.48 18" OPTION PIPE S IN  
 147.96 18" OPTION PIPE E OUT  
 149.46 18" OPTION PIPE N IN

STA. 316+11.37 RT  
 BUILD NEW 72" DIA. C.B.  
 T.C. 157.02  
 INV. 147.61 18" OPTION PIPE N IN  
 150.48 18" OPTION PIPE S IN  
 147.61 18" OPTION PIPE N IN  
 147.11 24" OPTION PIPE E OUT

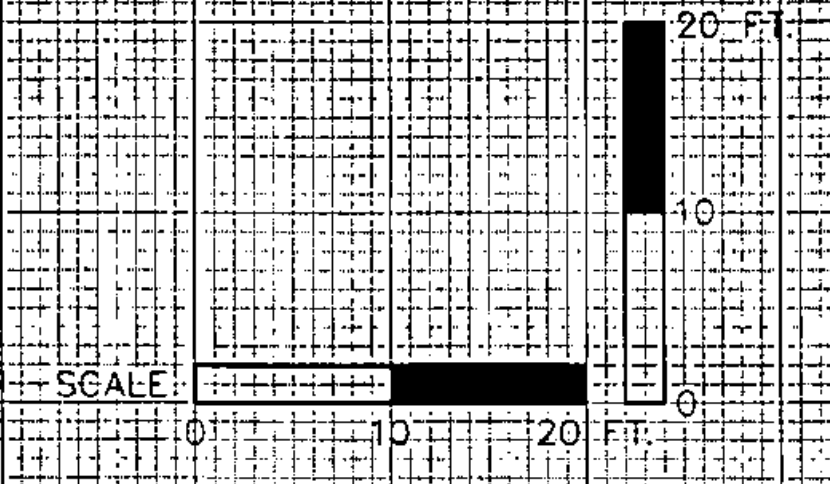

SHELburne  
 STA. 314+98 TO STA. 316+98  
 SURVEYED BY V.S.C. INC. DATE \_\_\_\_\_  
 DRAWN BY E.A.A. INC. DATE \_\_\_\_\_  
 TRACED BY E.A.A. INC. DATE \_\_\_\_\_  
 PROJECT NH-EGC-019-4(27)  
 CROSS-SECTION DWG. NO. 44  
 SHEET 357 OF 537

4/15/04

160 150 140 130 120 110 100 90 80 70 60 50 40 30 20 10 0 10 20 30 40 50 60 70 80 90 100 110 120