

DATUM ELEV. = 140.00

DATUM ELEV. = 150.00

DATUM ELEV. = 140.00

DATUM ELEV. = 140.00


STA. 317+97.80

STA. 317+58.80

STA. 317+47.80

STA. 316+97.80

STA. 317+00, 65' LT.  
 BUILD NEW 30" X 30" D.I.  
 T.G. 151.88  
 INV. 149.83 18" OPT. PIPE, S. OUT

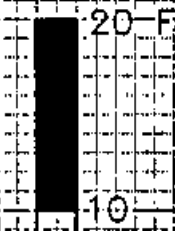

STA. 316+98 TO STA. 317+98  
 SURVEYED BY V.S.C. INC. DATE \_\_\_\_\_  
 DRAWN BY E.A.A. INC. DATE \_\_\_\_\_  
 TRACED BY E.A.A. INC. DATE \_\_\_\_\_  
 PROJECT NH-EGC-019-4(27)  
 CROSS-SECTION DWG. NO. 45  
 SHEET 358 OF 537

4/13/04