

STA. 323+67.41 5' RT.
 BUILD NEW 72" DIA. C.B.
 T.G. 155.70
 INV. 148.50 18" OPTION PIPE, N. OUT

STA. 323+57.40 RT.
 EXIST'G. 18" C.M.P. W/END SECTION
 INV. 153.08

STA. 323+57.94 RT.
 BUILD NEW 72" DIA. M.H. OUTLET STRUCTURE
 T.G. 150.24
 INV. 146.24 3" PIPE, E. IN
 145.10 30" OPTION PIPE, S. OUT

STA. 323+16.37 LT.
 BUILD NEW 48" DIA. C.B.
 T.G. 155.22
 INV. 149.92 18" OPTION PIPE, N. IN
 149.92 18" OPTION PIPE, S. OUT

STA. 322+98.00 = 140+00.00
 CONSTRUCT RELOCATED BAY ROAD

STA. 322+98.00 = 130+00.00
 CONSTRUCT RELOCATED EXECUTIVE DRIVE

STA. 322+77.17 LT. (FOUNDATION)
 DEMOLITION & DISPOSAL OF BLDG.

STA. 322+30.55 RT.
 BUILD NEW 48" DIA. M.H.
 T.G. 154.50
 INV. 144.34 30" OPTION PIPE, N. IN
 144.34 30" OPTION PIPE, S. OUT

STA. 322+46.80 LT.
 OUTLET @ MUNROE BROOK
 INV. 148.75

STA. 322+00.44 RT.
 EXIST'G. DROP INLET
 T.G. 151.42
 INV. 148.92

STA. 322+05.126 RT.
 EXIST'G. SANIT. MANHOLE #599
 T.G. 154.38
 INV. 145.05 IN
 INV. 143.05 OUT

STA. 321+73.27 LT.
 EXIST'G. DROP INLET
 T.G. 153.7
 INV. 145.85

STA. 321+42.105 LT.
 EXIST'G. 24" R.C.P.
 INV. 140.7

STA. 321+97.81
 STA. 322+47.81
 STA. 322+97.81
 STA. 323+47.81


DATUM ELEV. = 145.00

BAY ROAD
 MUNROE BROOK

NEW SEDIMENTATION POND

SEE X-SECTION DWG. NO. 131
 BAY ROAD - STA. 141+50

SHELBURNE

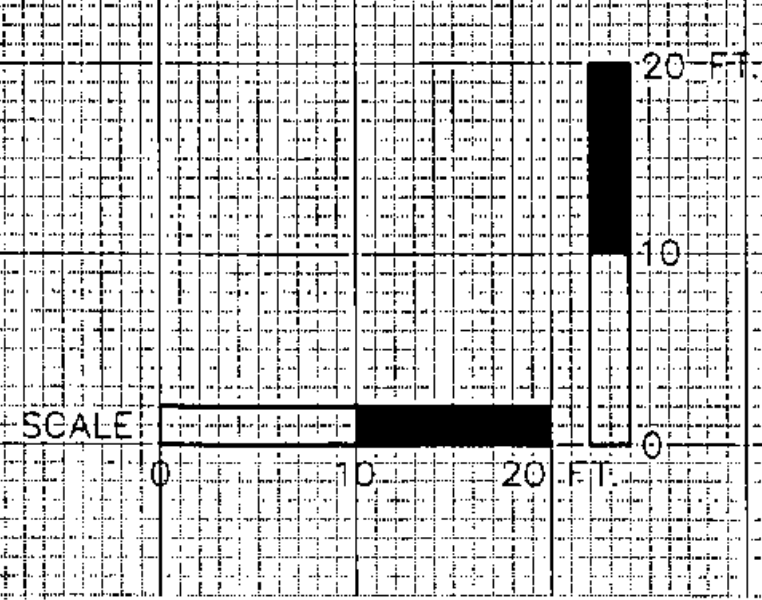

STA. 321+98 TO STA. 323+48
 SURVEYED BY V.S.C. INC. DATE _____
 DRAWN BY E.A.A. INC. DATE _____
 TRACED BY E.A.A. INC. DATE _____
 PROJECT NH-EGC-019-4(27)
 CROSS-SECTION DWG. NO. 48
 SHEET 361 OF 537

4/13/04