

DATUM ELEV. = 165.00

DATUM ELEV. = 165.00

DATUM ELEV. = 160.00

DATUM ELEV. = 160.00


STA. 337+51.81

STA. 337+47.81

STA. 337+14.81

STA. 336+97.81

CONSTRUCT HEDGEROW DRIVE
STA. 337+50.00 = 180+00.00

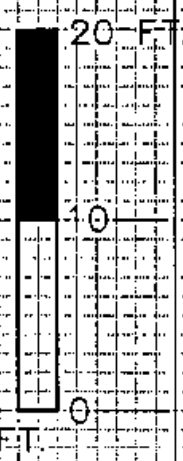

STA. 336+98 TO STA. 337+52
 SURVEYED BY V.S.C. INC. DATE _____
 DRAWN BY E.A.A. INC. DATE _____
 TRACED BY E.A.A. INC. DATE _____
 PROJECT NH-EGC-019-4(27)
 CROSS-SECTION DWG. NO. 58
 SHEET 371 OF 537

4/13/04