

DATUM ELEV. = 165.00

DATUM ELEV. = 165.00

DATUM ELEV. = 165.00

DATUM ELEV. = 165.00

STA. 339+47.81

STA. 338+97.81


STA. 338+47.81

STA. 337+97.81

STA. 337+85.62' RT.
 BUILD NEW 30" X 30" DIA.
 T.G. 167.00
 INV. 163.25-18" OPTION PIPE, E IN
 163.25-18" OPTION PIPE, W OUT

STA. 338+00.37' LT.
 BUILD NEW 48" DIA. C.B.
 T.G. 169.69
 INV. 163.15-18" OPTION PIPE, N IN
 163.15-18" OPTION PIPE, S OUT

STA. 338+00.37' RT.
 BUILD NEW 72" DIA. C.B.
 T.G. 169.77
 INV. 161.91-30" OPTION PIPE, N IN
 162.41-18" OPTION PIPE, E IN
 161.41-30" OPTION PIPE, S OUT

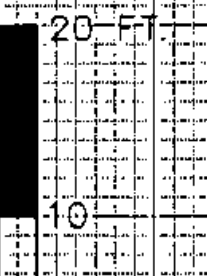

SHELburne
 STA. 337+98 TO STA. 339+48
 SURVEYED BY V.S.C. INC. DATE _____
 DRAWN BY E.A.A. INC. DATE _____
 TRACED BY E.A.A. INC. DATE _____
 PROJECT NH-EGC-019-4(27)
 CROSS-SECTION DWG. NO. 59
 SHEET 372 OF 537

4/13/04