

A131
Sta. 347+50
125' 11"
E.O. Sandy M.T.W. A-4
NLID
Sandy St.

DATUM ELEV. = 175.00

DATUM ELEV. = 175.90

DATUM ELEV. = 175.00


DATUM ELEV. = 175.00

SAVE
12' POPLAR
SAVE
12' POPLAR
CONSTRUCT LAKEVIEW DRIVE
STA. 346+39.74 = 210+00.00

STA. 346+81.37' LT.
BUILD NEW 48" DIA. C.B.
T.G. 182.40'
INV. 175.86' 18" OPTION PIPE, N IN
175.86' 18" OPTION PIPE, S OUT

STA. 346+81.42' RT.
BUILD NEW 48" DIA. C.B.
T.G. 182.40'
INV. 175.07' 24" OPTION PIPE, N IN
175.07' 18" OPTION PIPE, E IN
174.57' 24" OPTION PIPE, S OUT

STA. 346+58.72' RT.
BUILD NEW 30"x30" D.I.
T.G. 179.80'
INV. 175.94' 18" OPTION PIPE, W OUT

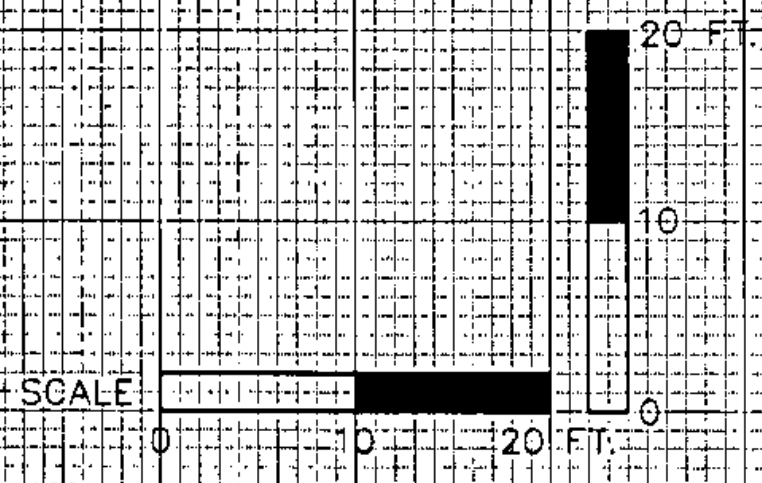

STA. 346+33 TO STA. 347+48
SURVEYED BY V.S.C. INC. DATE _____
DRAWN BY E.A.A. INC. DATE _____
TRACED BY E.A.A. INC. DATE _____
PROJECT NH-EGC-019-4(27)
CROSS-SECTION DWG. NO. 65
SHEET 378 OF 537

4/13/04