


STA. 348+00 TO STA. 349+10
 SURVEYED BY V.S.C. INC. DATE _____
 DRAWN BY E.A.A. INC. DATE _____
 TRACED BY E.A.A. INC. DATE _____
 PROJECT NH-EGC-019-4(27)
 CROSS-SECTION DWG. NO. 66
 SHEET 379 OF 537

4/13/04

SHELburne

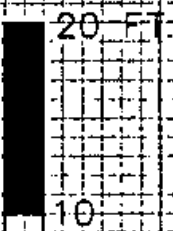

160 150 140 130 120 110 100 90 80 70 60 50 40 30 20 10 0 10 20 30 40 50 60 70 80 90 100 110 120

DATUM ELEV. = 180.00

DATUM ELEV. = 180.00

DATUM ELEV. = 175.00

DATUM ELEV. = 175.00

STA. 349+07.81

STA. 348+97.81

STA. 348+47.81

STA. 347+97.81

STA. 348+20.81-R1
 EXISTING SANIT. MANHOLE 18" DIA.
 INV. 176.95 IN 8" V.C.
 INV. 176.43 OUT 8" P.V.C.

NEW SMH #110-R