


DATUM ELEV. = 185.00

STA. 353+00 = 358+32.5 45' LT
INST. NEW 2" DRISCO GAS

DATUM ELEV. = 185.00

DATUM ELEV. = 185.00

DATUM ELEV. = 185.00

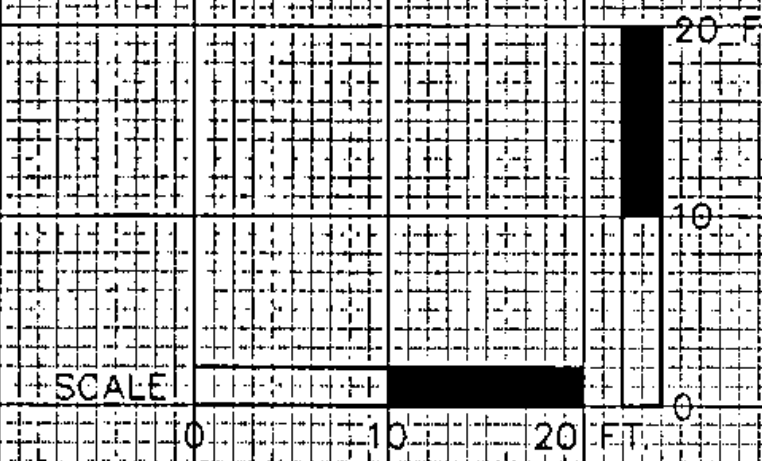

STA. 351+98 TO STA. 352+98
 SURVEYED BY V.S.C. INC. DATE _____
 DRAWN BY E.A.A. INC. DATE _____
 TRACED BY E.A.A. INC. DATE _____
 PROJECT NH-EGC-019-4(27)
 CROSS-SECTION DWG. NO. 69
 SHEET 382 OF 537

4/13/04

180 150 140 130 120 110 100 90 80 70 60 50 40 30 20 10 0 10 20 30 40 50 60 70 80 90 100 110 120

NS

SHELBURNE