

DATUM ELEV. = 190.00

DATUM ELEV. = 185.00

DATUM ELEV. = 190.00

DATUM ELEV. = 190.00

STA. 356+83.83


STA. 356+47.83

STA. 356+20.82

STA. 355+97.81

STA. 353+00 - 356+32.5 45' LT  
INST. NEW 2" DRISCO GAS

STA. 356+65.37 RT  
BUILD NEW 48" DIA. C.B.  
T.G. 197.25  
INV. 186.70 24" OPTION PIPE N-IN.  
INV. 186.70 24" OPTION PIPE S-OUT

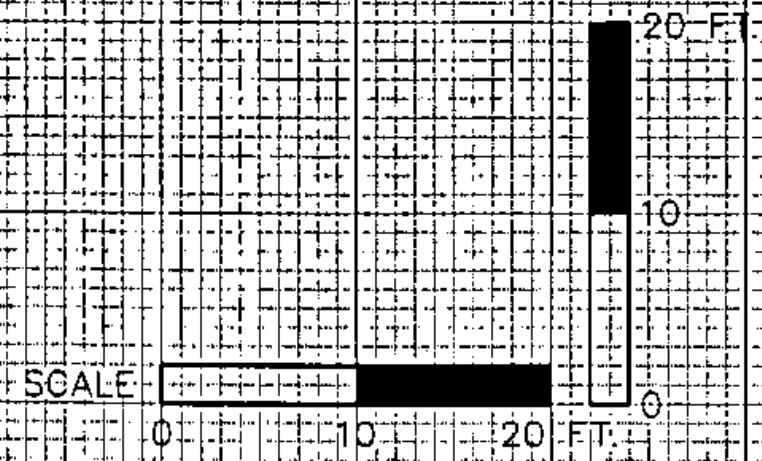

SHELBURNE  
 STA. 355+98 TO STA. 356+84  
 SURVEYED BY V.S.C. INC. DATE \_\_\_\_\_  
 DRAWN BY E.A.A. INC. DATE \_\_\_\_\_  
 TRACED BY E.A.A. INC. DATE \_\_\_\_\_  
 PROJECT NH-EGC-019-4(27)  
 CROSS-SECTION DWG. NO. 72  
 SHEET 385 OF 537

4/13/04