

DATUM ELEV. = 190.00

DATUM ELEV. = 190.00


DATUM ELEV. = 190.00

DATUM ELEV. = 190.00

CONSTRUCT DRIVE (PENNY LANE)
STA 361+57.00 = 290+00.00

STA 360+55.37 L.I.
BUILD NEW 48" DIA. C.B.
T.G. 195.99
INV. 189.10 18" OPTION PIPE N IN
189.10 18" OPTION PIPE S OUT

STA 360+55.37 RT.
BUILD NEW 48" DIA. C.B.
T.G. 195.99
INV. 189.15 18" OPTION PIPE N IN
189.15 18" OPTION PIPE S OUT

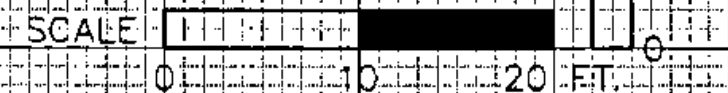

STA. 360+48 TO STA. 361+78

SURVEYED BY Y.S.C. INC. DATE _____
DRAWN BY E.A.A. INC. DATE _____
TRACTED BY E.A.A. INC. DATE _____

PROJECT NH-EGC-019-4(27)
CROSS-SECTION DWG. NO. 75
SHEET 388 OF 537

4/13/04

SHELBURNE