

DATUM ELEV. = 190.00

DATUM ELEV. = 190.00

DATUM ELEV. = 190.00

DATUM ELEV. = 190.00

CONSTRUCT DRIVE
STA. 364+13.00 = 310+00.00

STA. 363+80 - 368+77 48"
INST. NEW 2" X TRU GAS

STA. 364+13.83

STA. 363+97.83

STA. 363+47.83

STA. 363+07.83


CONSTRUCT MARTINDALE ROAD
STA. 364+13.00 = 300+00.00

STA. 363+78.74 RT. =
STA. 300+74.35 RT. (MARTINDALE RD.)
BUILD NEW 30" X 30" D.I.
T.G. 196.90
INV. 192.09 18" OPTION PIPE N. OUT

STA. 363+92.59 RT.
EXIST'G CONC HEADWALL
INV. 196.58 12" R.C.P.

STA. 363+75.120 RT.
EXIST'G 12" R.C.P.
INV. 198.7

STA. 363+30 - 37+45 RT.
INST. NEW 16" X TRU GAS

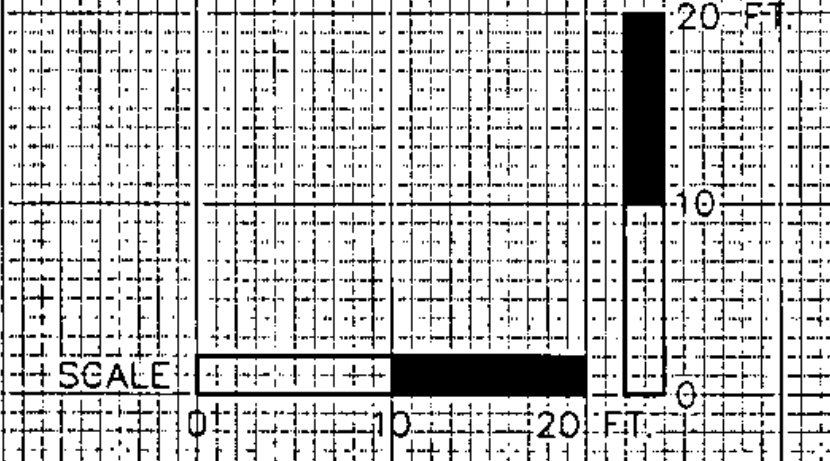

STA. 363+08 TO STA. 364+14

SURVEYED BY V.S.C. INC. DATE _____
DRAWN BY E.A.A. INC. DATE _____
TRACED BY E.A.A. INC. DATE _____

PROJECT NH-EGC-019-4(27)
CROSS-SECTION DWG. NO. 77
SHEET 390 OF 537

4/13/04

160 150 140 130 120 110 100 90 80 70 60 50 40 30 20 10 0 10 20 30 40 50 60 70 80 90 100 110 120