

DATUM ELEV. = -190.00

DATUM ELEV. = -190.00

STA. 367+47.83

STA. 367+22.83


STA. 366+97.83

STA. 366+80.83

STA. 366+69.83

STA. 366+80 = 366+77.146 LT  
INST. NEW 2" X TRU GAS

STA. 366+80 = 37.765 RT  
INST. NEW 6" X TRU GAS

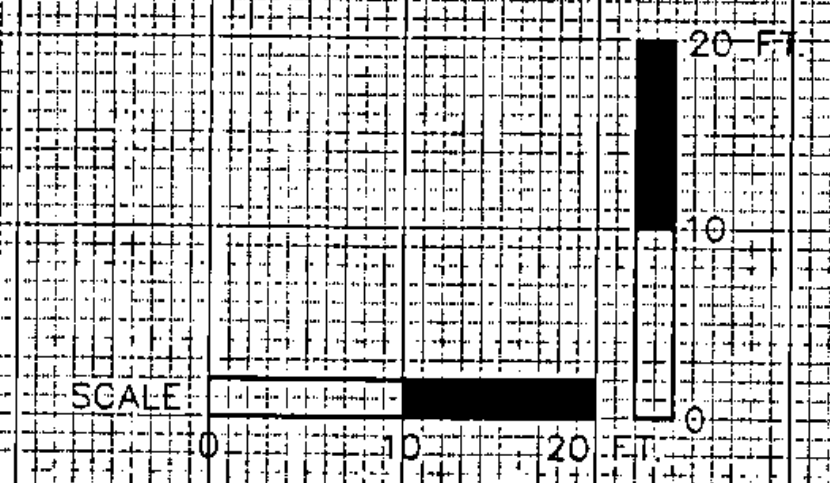

SHELBURNE  
 STA. 366+70 TO STA. 367+48  
 SURVEYED BY V.S.C. INC. DATE \_\_\_\_\_  
 DRAWN BY E.A.A. INC. DATE \_\_\_\_\_  
 TRACED BY E.A.A. INC. DATE \_\_\_\_\_  
 PROJECT NH-EGC-019-4(27)  
 CROSS-SECTION DWG. NO. 80  
 SHEET 393 OF 537

160 150 140 130 120 110 100 90 80 70 60 50 40 30 20 10 0 10 20 30 40 50 60 70 80 90 100 110 120