

DATUM ELEV = 185.00

DATUM ELEV = 190.00

DATUM ELEV = 190.00


DATUM ELEV = 190.00

CONSTRUCT PINE HAVEN SHORES ROAD  
STA. 371+89.87 = 330+00.00

CONSTRUCT LOCUST HILL DRIVE  
STA. 371+89.87 = 320+00.00

STA. 371+40.41-5' LT.  
BUILD NEW 72" DIA. C.B.  
T.G. 195.06  
INV. 186.97 18" OPTION PIPE, S IN  
186.97 18" OPTION PIPE, E IN  
186.47 18" OPTION PIPE, W OUT

STA. 371+50.37 RT.  
BUILD NEW 72" DIA. C.B.  
T.G. 195.22  
INV. 187.66 18" OPTION PIPE, S IN  
187.66 18" OPTION PIPE, N IN  
187.36 18" OPTION PIPE, W OUT

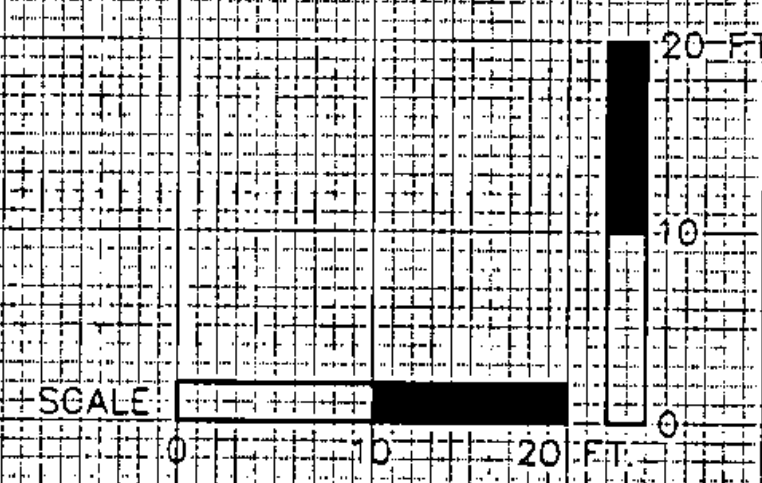

SHELburne  
 STA. 370+98 TO STA. 371+98  
 SURVEYED BY V.S.C. INC. DATE \_\_\_\_\_  
 DRAWN BY E.A.A. INC. DATE \_\_\_\_\_  
 TRACED BY E.A.A. INC. DATE \_\_\_\_\_  
 PROJECT NH-EGC-019-4(27)  
 CROSS-SECTION DWG. NO. 84  
 SHEET 397 OF 537