

DATUM ELEV. = 165.00

DATUM ELEV. = 165.00

DATUM ELEV. = 165.00

DATUM ELEV. = 165.00

STA. 42+00

STA. 41+50

STA. 41+00

STA. 40+50

EXISTING BLOC.

SEE MAINLINE SECTIONS  
STA. 285+97.80

MAINTENANCE  
DITCH


GRADE ELEV. 170.08

GRADE ELEV. 171.66

GRADE ELEV. 172.58

GRADE ELEV. 172.97

SCALE 0 10 20 FT.

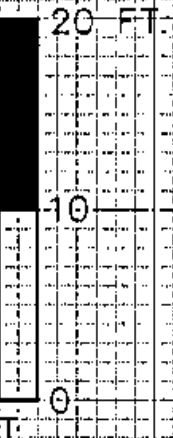

LONGMEADOW DRIVE

SHELburne

STA. 40+50 TO STA. 42+00

SURVEYED BY V.S.C. INC. DATE  
DRAWN BY E.A.A. INC. DATE  
TRACED BY E.A.A. INC. DATE

PROJECT NH-EGC-019-4(27)

CROSS-SECTION DWG. NO. 125

SHEET 404 OF 537

4/13/04

160 150 140 130 120 110 100 90 80 70 60 50 40 30 20 10 0 10 20 30 40 50 60 70 80 90 100 110 120