

DATUM ELEV = 165.00

DATUM ELEV = 165.00

DATUM ELEV = 165.00

DATUM ELEV = 165.00


EXISTING BLDG #27  
STA. 91+58 TO 91+61

STA. 91+00, 14' LT.  
BUILD NEW 48" DIA. C.B.  
T.G. 170.12  
INV. 164.10 18" OPTION PIPE IN OUT

STA. 91+00, 16' RT.  
BUILD NEW 48" DIA. C.B.  
T.G. 170.02  
INV. 163.95 18" OPTION PIPE S-IN  
163.95 18" OPTION PIPE E-OUT

SEE MAINLINE SECTIONS  
STA. 301+47.80

EXISTING BLDG  
STA. 90+33 TO 37 RT. TO  
STA. 90+87.56 RT.

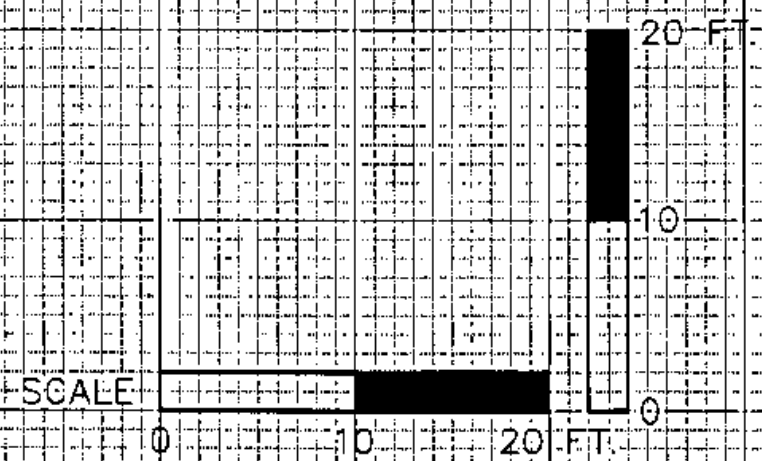

MAPLE LEAF LANE

SHELBURNE

STA. 90+50 TO STA. 92+00

SURVEYED BY V.S.C. INC. DATE

DRAWN BY E.A.A. INC. DATE

TRACED BY E.A.A. INC. DATE

PROJECT NH-EGC-019-4(27)

CROSS-SECTION DWG. NO. 128

SHEET 407 OF 537

4/13/04

160 150 140 130 120 110 100 90 80 70 60 50 40 30 20 10 0 10 20 30 40 50 60 70 80 90 100 110 120