

DATUM ELEV = 145.00

STA. 111+50

DATUM ELEV = 145.00

STA. 111+00

DATUM ELEV = 145.00

STA. 110+50


SEE MAINLINE SECTIONS  
STA. 311+85.80

SEE MAINLINE SECTIONS  
STA. 311+85.80

STA. 110+62, 31' LT.  
BUILD NEW 30" X 30" D.I.  
T.G. 158.00  
INV. 154.32 18" OPTION PIPE, E OUT

STA. 110+57, 44' RT.  
BUILD NEW 30" X 30" D.I.  
T.G. 159.83  
INV. 155.20 18" OPTION PIPE, E OUT

DRIVEWAY @ 311+81, LT.

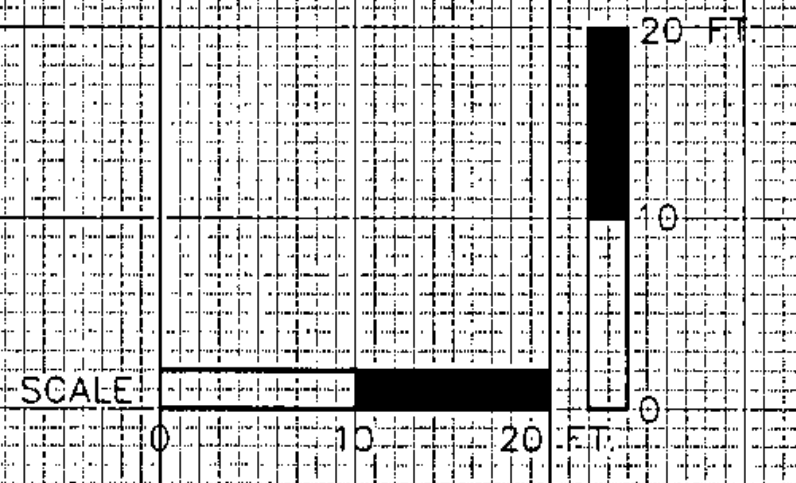

STA. 110+50 TO STA. 111+00  
 SURVEYED BY V.S.C. INC. DATE \_\_\_\_\_  
 DRAWN BY E.A.A. INC. DATE \_\_\_\_\_  
 TRACED BY E.A.A. INC. DATE \_\_\_\_\_  
 PROJECT NH-EGC-019-4(27)  
 CROSS-SECTION DWG. NO. 129  
 SHEET 408 OF 537

4/13/04