

STA 133+83.15 LT.
 BUILD NEW 48" DIA. C.B.
 T.G. 154.62
 INV. 150.15 18" OPTION PIPE S' OUT

STA 133+83.15 RT.
 BUILD NEW 48" DIA. C.B.
 T.G. 154.62
 INV. 150.00 18" OPTION PIPE N IN
 149.54 EXISTING 12" P.V.C. E-OUT

DATUM ELEV. = 150.00

DATUM ELEV. = 150.00


STA 133+78

STA 133+26
 STA 133+52

STA 133+04.15 LT.
 EXIST'G DROP INLET
 T.G. 153.35
 INV. 151.29 12" P.V.C.

STA 133+00.15 RT.
 EXIST'G DROP INLET
 T.G. 153.35
 INV. 151.29 12" P.V.C.

NEW SMH #225A
 STA 132+88.07 LT. (EXISTING)
 STA 133+19.17 LT. (NEW C.)

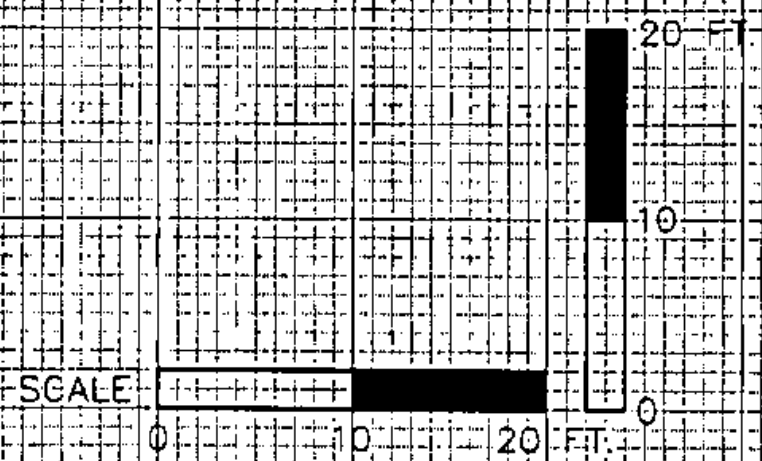

EXECUTIVE DRIVE

SHELBURNE

STA 133+26 TO STA 133+78

SURVEYED BY V.S.C. INC. DATE _____
 DRAWN BY E.A.A. INC. DATE _____
 TRACED BY E.A.A. INC. DATE _____

PROJECT NH-EGC-019-4(27)
 CROSS-SECTION DWG. NO. 130B
 SHEET 410 OF 537

4/13/04

160 150 140 130 120 110 100 90 80 70 60 50 40 30 20 10 0 10 20 30 40 50 60 70 80 90 100 110 120

OF EXISTING EXECUTIVE DRIVE