

DATUM ELEV. = 140.00

DATUM ELEV. = 135.00

DATUM ELEV. = 135.00

DATUM ELEV. = 135.00

DATUM ELEV. = 145.00


STA. 141+92.019 - 36.598' LT.
 BUILD NEW 9' X 17' BOX CULVERT
 INLET INVERT ELEV. = 135.15 (CONC.)

STA. 141+30.965 - 36.164' LT.
 BUILD NEW 9' X 17' BOX CULVERT
 OUTLET INVERT ELEV. = 134.50 (CONC.)

OUTLET (18' R.C.P.)
 STA. 140+88.51' LT.
 INV. 148.75

EXISTING BLDG. #3426 SHELBORNE RD.
 DEMOLITION & DISPOSAL OF BLDG. (FOUNDATION)
 @ STA. 322+77' LT. (Shelburne Road)

NEW SMH #93C
 STA. 323+82.785' LT.
 (Shelburne Rd.)

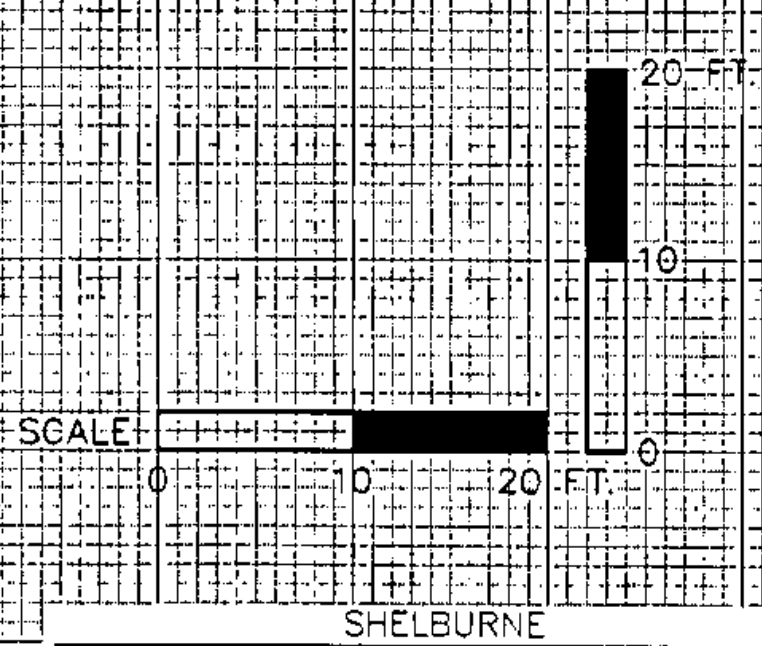

STA. 141+00 TO STA. 143+00
 SURVEYED BY: V.S.C. INC. DATE: _____
 DRAWN BY: E.A.A. INC. DATE: _____
 TRACED BY: E.A.A. INC. DATE: _____
 PROJECT: NH-EGC-019-4(27)
 CROSS-SECTION DWG. NO. 131
 SHEET 411 OF 537

4/13/04

160 150 140 130 120 110 100 90 80 70 60 50 40 30 20 10 0 10 20 30 40 50 60 70 80 90 100 110 120