

DATUM ELEV = 165.007

STA. 191+30

GRADE ELEV. 171.50  
0.021

DATUM ELEV = 165.001

STA. 191+00

GRADE ELEV. 172.01  
0.021

DATUM ELEV = 165.00


STA. 190+50

GRADE ELEV. 174.11  
0.021

SEE MAINLINE SECTIONS  
STA. 341+97.81

MATCH TO SEC.  
DWG. NO. 16

10

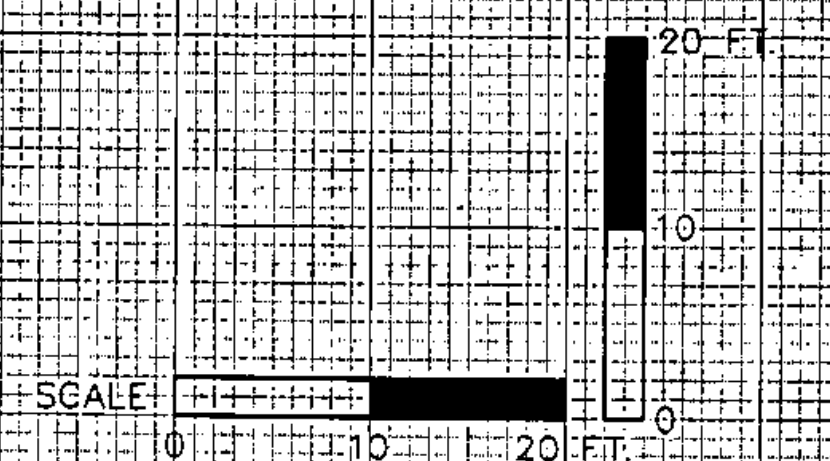

TAMARACK ROAD

SHELburne

STA. 190+50 TO STA. 191+30  
 SURVEYED BY V.S.C. INC. DATE \_\_\_\_\_  
 DRAWN BY E.A.A. INC. DATE \_\_\_\_\_  
 TRACED BY E.A.A. INC. DATE \_\_\_\_\_  
 PROJECT NH-EGC-019-4(27)  
 CROSS-SECTION DWG. NO. 134  
 SHEET 414 OF 537

4/13/04

160 150 140 130 120 110 100 90 80 70 60 50 40 30 20 10 0 10 20 30 40 50 60 70 80 90 100 110 120