

STA. 201+34.23
EXIST'G STONE HEADWALL
INV. 175.18' STORM PIPE

GRADE ELEV. 164.23
0.021

DATUM ELEV. = 175.00

EXIST'G 8" SAN
STA. 201+30

0-5

GRADE ELEV. 163.32
0.021

DATUM ELEV. = 175.00

STA. 346+58.72 RT. =
200+72.34 LT.
BUILD NEW 30"x30" D.I.
T.C. 181.00
INV. 175.94 18" OPTION PIPE W/OUT

EXIST'G 8" SAN

STA. 201+00

EXIST'G 8" W/S ER

DATUM ELEV. = 175.00


SEE MAINLINE SECTIONS
STA. 345+97.81

GRADE ELEV. 161.75
0.021

EXIST'G 8" SAN

STA. 200+50

SEE MAINLINE SECTIONS
STA. 345+97.81

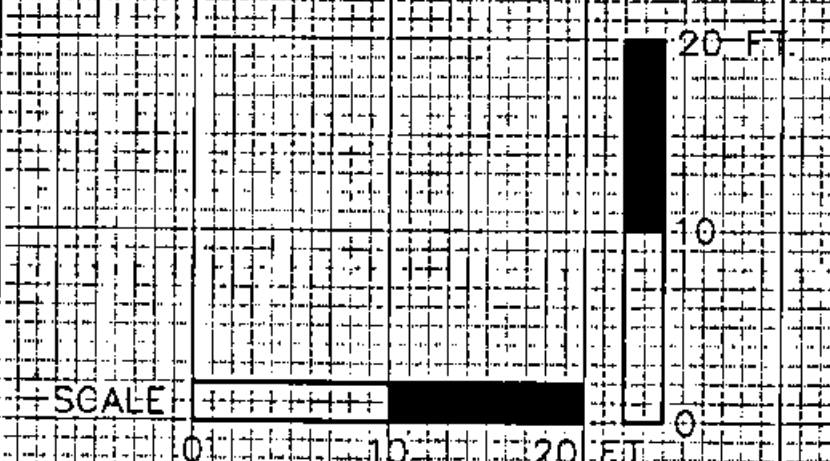

HULLCREST ROAD

SHELBURNE

STA. 200+50 TO STA. 201+30

SURVEYED BY V.S.C. INC. DATE _____
DRAWN BY E.A.A. INC. DATE _____
TRACED BY E.A.A. INC. DATE _____

PROJECT NH-EGC-019-4(27)
CROSS-SECTION DWG. NO. 135

SHEET 415 OF 537

4/13/04

160 150 140 130 120 110 100 90 80 70 60 50 40 30 20 10 0 10 20 30 40 50 60 70 80 90 100 110 120