


DATUM ELEV. = 185.00

DATUM ELEV. = 185.00

DATUM ELEV. = 185.00

DATUM ELEV. = 185.00

160 150 140 130 120 110 100 90 80 70 60 50 40 30 20 10 0 10 20 30 40 50 60 70 80 90 100 110 120

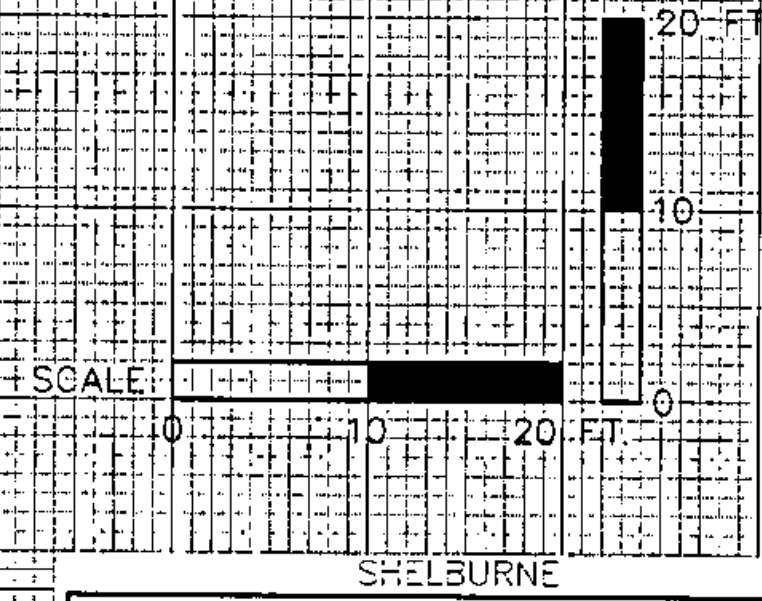

JUNIPER RIDGE
SHELBURNE

STA. 250+50 TO STA. 252+00

SURVEYED BY V.S.C. INC. DATE _____

DRAWN BY E.A.A. INC. DATE _____

TRACED BY E.A.A. INC. DATE _____

PROJECT NH-EGC-019-4(27)

CROSS-SECTION DWG. NO. 137B

SHEET 418 OF 537

4/13/04