

STA. 281+00: 21' LT
24" OPTION PIPE-OUTLET W/ END-SECTION
INV. 187.79

DATUM ELEV. = 185.00

STA. 280+99: 18' LT
EXIST'G: 24" R.C.P.
INV. 187.1

STA. 281+00

EXISTING METAL SHED
STA. 280+88: 19' RT
TO 280+93: 13' RT

STA. 280+65: 13' RT
EXIST'G: 24" R.C.P.
INV. 187.1

EXISTING MOBILE HOME
STA. 280+74: 13' RT
TO 280+86: 11' RT

STA. 280+57: 22' RT
EXIST'G: 24" R.C.P.
INV. 191.84

EXISTING WOOD SHED
STA. 280+41: 33' RT
TO 280+60: 13' RT


DATUM ELEV. = 190.00

SEE MAINLINE SECTIONS
STA. 359+47.83

MATCH TO X-SECT
DWG. NO. 177

STA. 280+50

EXIST'G: 24" R.C.P.

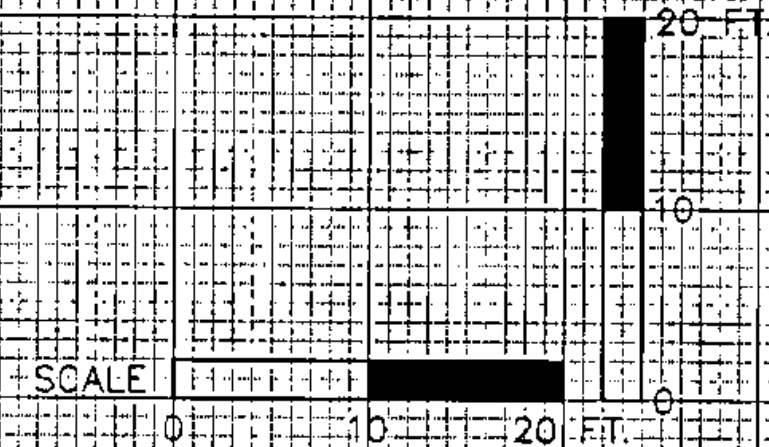

WINDMILL BAY ROAD

SHELBURNE

STA. 280+50 TO STA. 281+00

SURVEYED BY: V.S.C. INC. DATE: _____

DRAWN BY: E.A.A. INC. DATE: _____

TRACED BY: E.A.A. INC. DATE: _____

PROJECT: NH-EGC-019-4(27)

CROSS-SECTION DWG. NO. 139

SHEET 420 OF 537

4/13/04

160 150 140 130 120 110 100 90 80 70 60 50 40 30 20 10 0 10 20 30 40 50 60 70 80 90 100 110 120