


STA. 310+05.108 ± RT  
 24" R.C.P. OUTLET  
 INV. 171.00

DITCH @  
 Shelburne Rd. 310+05 ± RT

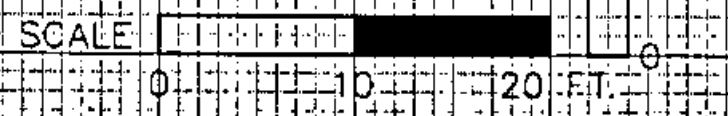

160 150 140 130 120 110 100 90 80 70 60 50 40 30 20 10 0 10 20 30 40 50 60 70 80 90 100 110 120

STA. 20+00 TO STA. 20+72  
 SURVEYED BY V.S.C. INC. DATE \_\_\_\_\_  
 DRAWN BY E.A.A. INC. DATE \_\_\_\_\_  
 TRACED BY E.A.A. INC. DATE \_\_\_\_\_  
 PROJECT NH-EGC-019-4(27)  
 CROSS-SECTION DWG. NO. 153  
 SHEET 426 OF 537

4/13/04