


DATUM
 VERTICAL NGVD 1929
 HORIZONTAL NAD 1927

4/13/04

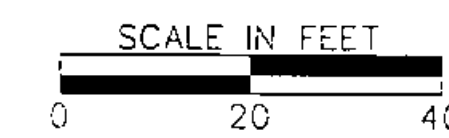

SHELBURNE
 SURVEYED BY V.S.C. INC. DATE _____
 DRAWN BY E.A.A. INC. DATE _____
 TRACED BY E.A.A. INC. DATE _____
 PROJECT NH-EGC-019-4(27)
 CONTOUR DRAWING NO. 3
 SHEET NO. 436 OF 537