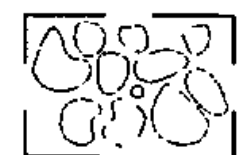


PHASE 1 CONSTRUCTION PLAN
Scale: 1"=10'-0"

 Limits of Stone Fill, Type II

STATE OF VERMONT AGENCY OF TRANSPORTATION			
Town Or	SHELBURNE	Bridge No.	145
Highway No.	U.S. ROUTE 7	Log Sta.	198+79
		Surv. Sta.	319+30
U.S. ROUTE 7 OVER MUNROE BROOK PHASE 1 CONSTRUCTION PLAN			
Designed By	L. Jenk	Drawn By	S. Scheffer
Checked By	J. Corliss	Bridge Design Supervisor	W. Windus
Date	April 2003	Date	April 2003
PROJECT	SHELBURNE	PROJECT NO.	NHEGC FECC 019-4(27)
I.G.C. Info.			
Bridge Sheet No.	BC105	Sheet	445 of 537

ERDMAN ANTHONY
CONSULTING ENGINEERS
Rochester, New York Comp. Hq., Pennsylvania
Boston, Massachusetts