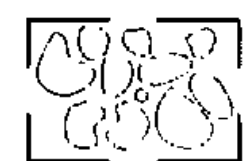


**PHASE 2 CONSTRUCTION PLAN**  
Scale: 1"=10'-0"

 Limits of Stone Fill, Type II

<b>STATE OF VERMONT AGENCY OF TRANSPORTATION</b>			
Town Of	SHELBURNE	Bridge No.	145
Highway No.	U.S. ROUTE 7	Loc. Sta.	196+79
		Surv. Sta.	319+30
<b>U.S. ROUTE 7 OVER MUNROE BROOK PHASE 2 CONSTRUCTION PLAN</b>			
Designed By	L.Janik	Drawn By	S.Schaffer
Checked By	J.Carliss	Bridge Design Supervisor	W.Windus
	April 2003	Date	April 2003
PROJECT	SHELBURNE	PROJECT NO.	NHEGC FECC 019-4(27)
J.G.C. Info.		Bridge Sheet No.	EC106
		Sheet	446 of 537

**ERDMAN ANTHONY  
CONSULTING ENGINEERS**  
Rochester, New York    Comp. Hill, Pennsylvania  
Boston, Massachusetts