



EXISTING CULVERT SECTION

Scale: 1"=10'-0"

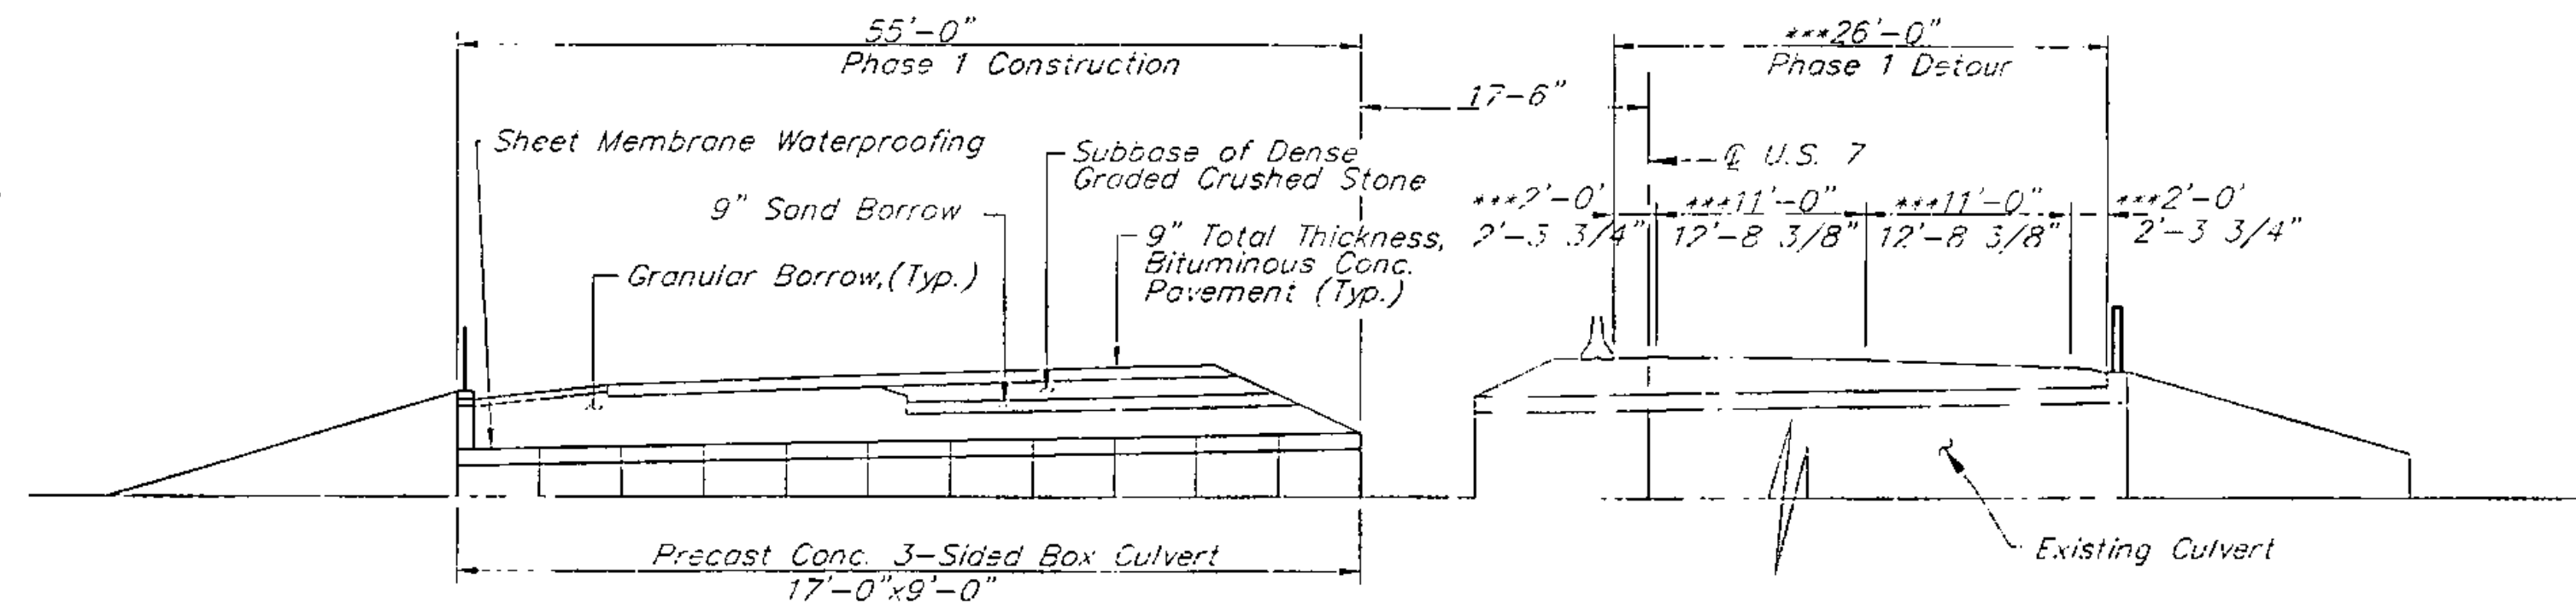


PHASE 1 CONSTRUCTION SECTION

Scale: 1"=10'-0"

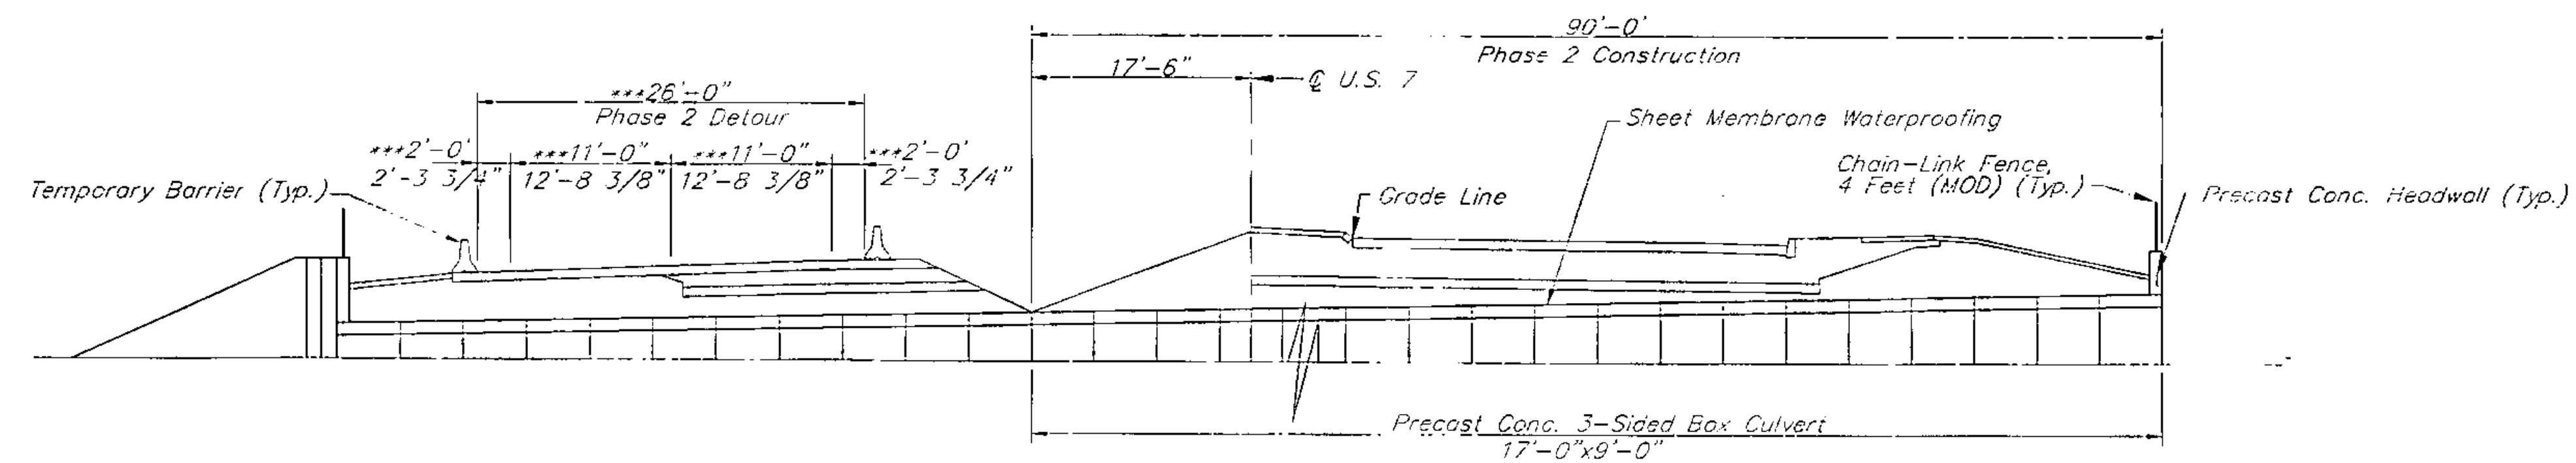

PHASE 2 CONSTRUCTION SECTION

Scale: 1"=10'-0"

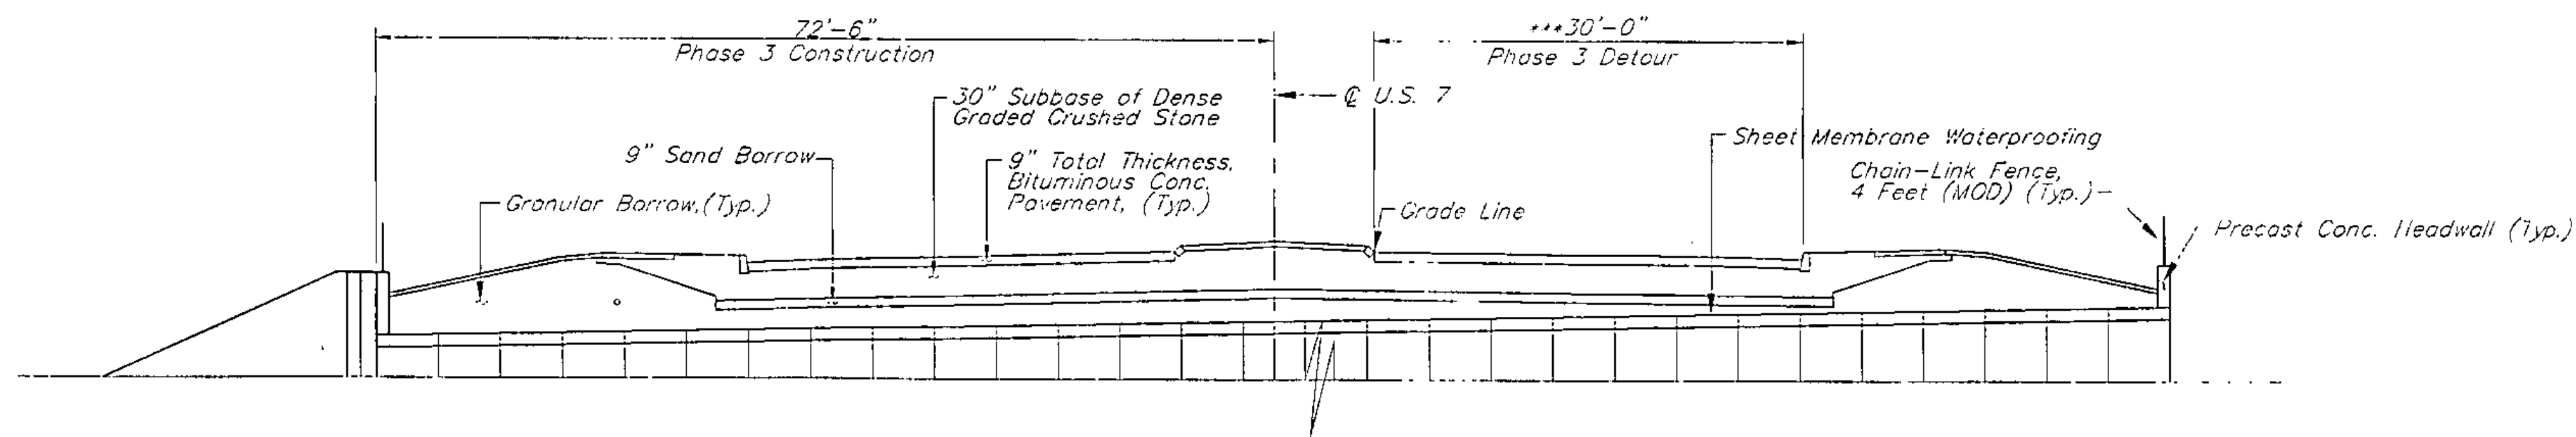

PHASE 3 CONSTRUCTION SECTION

Scale: 1"=10'-0"

--- Indicates dimensions that are perpendicular to the U.S. 7 centerline.

**STATE OF VERMONT
AGENCY OF TRANSPORTATION**

Town Of	SHELBURNE	Bridge No.	145
Highway No.	U.S. ROUTE 7	Loc. Sta.	196+79
		Surv. Sta.	319+30
U.S. ROUTE 7 OVER MUNROE BROOK			
PHASE 1, 2, AND 3 CONST. SECTIONS			
Designed By	L. Janik	Drawn By	S. Schaffer
Checked By	J. Corliss	Bridge Design Supervisor	W. Windus
Date	April 2003	Date	April 2003
PROJECT	SHELBURNE	PROJECT NO.	NHEGC FECC 019-4(27)
I.G.C. Info.			
Bridge Sheet No.	EC107	Sheet	447 of 537

ERDMAN ANTHONY
CONSULTING ENGINEERS
Rochester, New York Camp Hill, Pennsylvania
Boston, Massachusetts