



DATUM ELEV. = 140.0

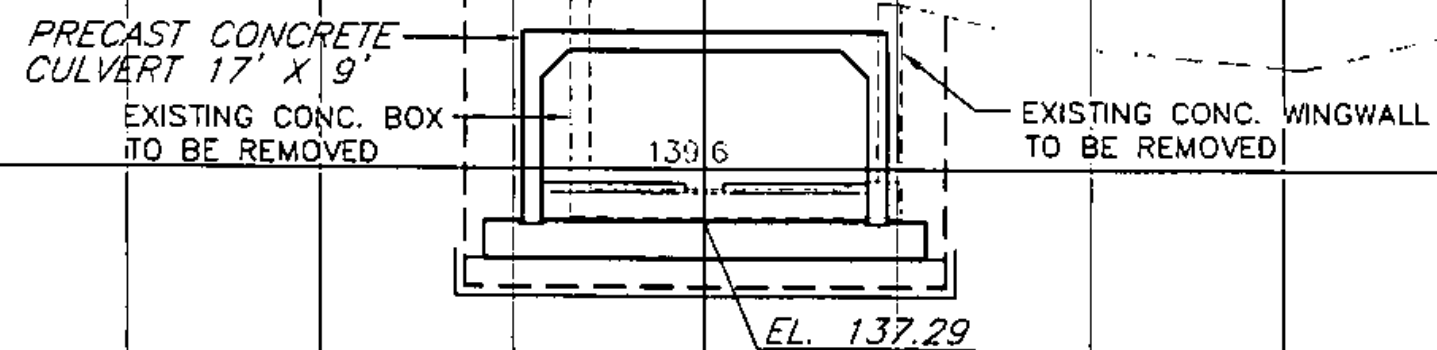


119+70

DATUM ELEV. = 140.0

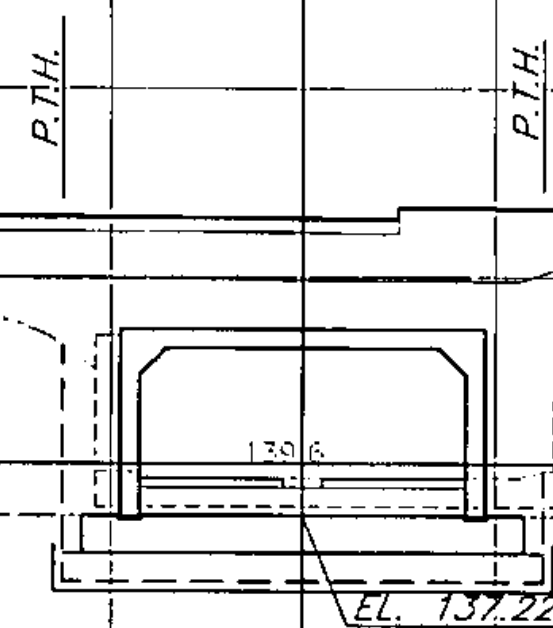


119+60

DATUM ELEV. = 140.0

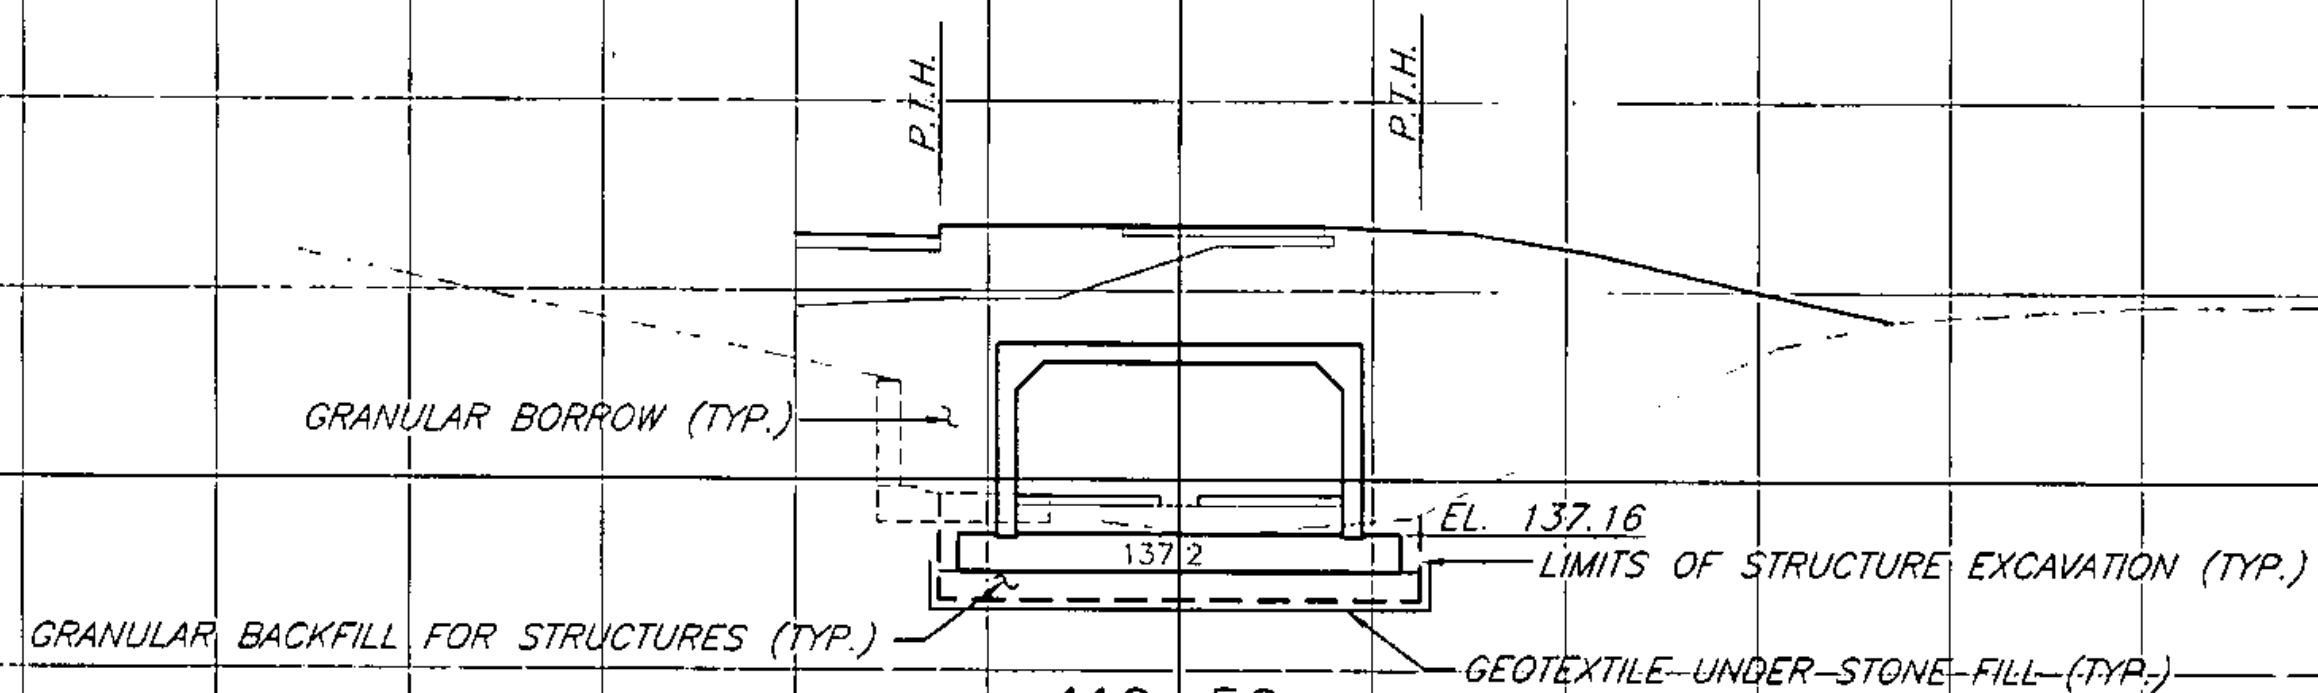


119+50

DATUM ELEV. = 140.0

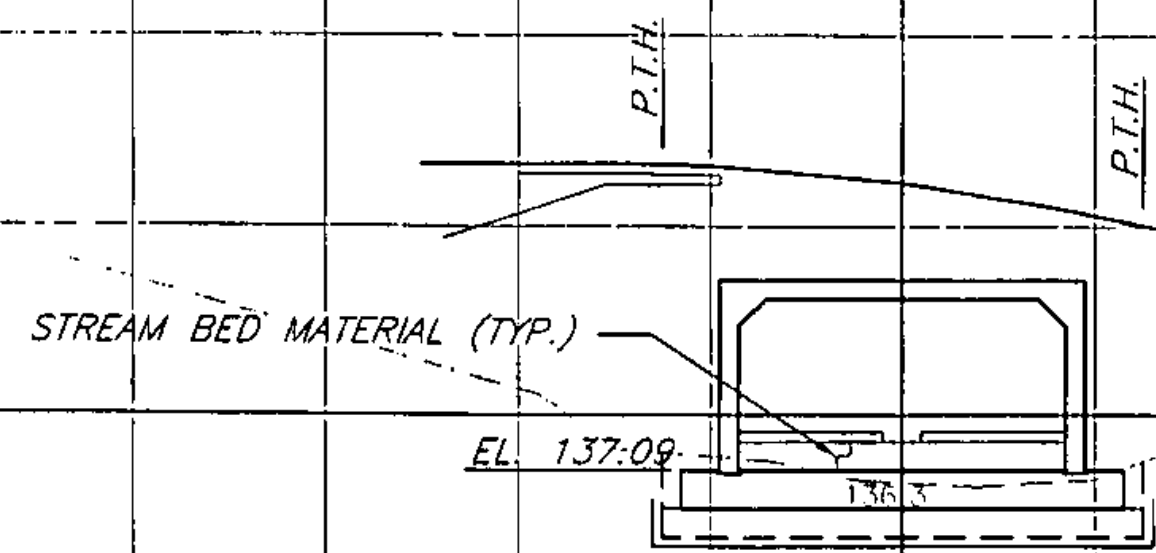

119+40

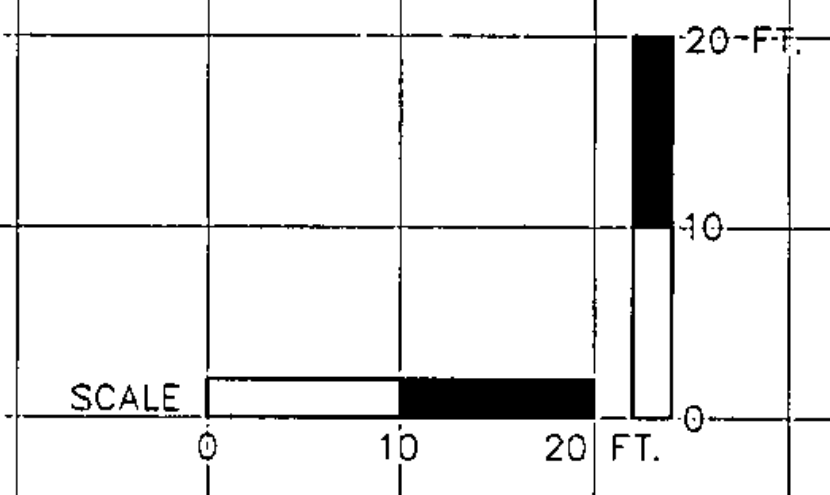

<b>STATE OF VERMONT</b> AGENCY OF TRANSPORTATION			
Town Of	SHELBURNE	Bridge No.	145
Highway No.	U.S. ROUTE 7	Loc. Sta.	196+79
		Surv. Sta.	319+30
U.S. ROUTE 7 OVER MUNROE BROOK			
X-SECTIONS STA. 119+40 to 119+70			
Designed By	L. Jonik	Drawn By	S. Schaffer
Checked By	J. Corliss	Bridge Design Supervisor	W. Windus
	April 2003	Date	April 2003
PROJECT	SHELBURNE	PROJECT NO.	NHEGC FECC 019-4(27)
I.G.C. Info.			
Bridge Sheet No.	BC110	Sheet	450 of 537

**ERDMAN ANTHONY**  
CONSULTING ENGINEERS  
Rochester, New York    Comp. Hill, Pennsylvania  
Boston, Massachusetts