


PLAN  
1" = 30'

**RECORD DRAWING REVISIONS**

| NO/DATE     | DESCRIPTION                       |
|-------------|-----------------------------------|
| 1. 11/10/09 | FIELD MARK UPS ADDED TO THE PLANS |

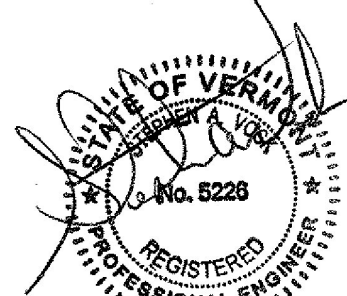

Shelburne NH EGC 019-4 (27)  
Sheet 478 of 537

TOWN OF SHELBURNE  
SEWER/WATER RELOCATION (AOT WORK)  
PLAN OF BAY ROAD  
AND EXECUTIVE DRIVE

| Date     | Ch'kd   | Revision   |
|----------|---------|--|
| 1-5-04   | SAV/ACL | REV'D WATER SYSTEM AS PER "AS BUILT" INFORMATION |
| 10-21-03 | SAV/ACL | REV'D SEWER & WATER AS PER AOT REVIEW COMMENTS   |
| 7-21-03  | SAV/ACL | REVISED  |

Drawn by ACL Date JAN., 2001  
 Checked by SAV Scale 1" = 30'  
 Approved by SAV Project No. 96111

SHELBURNE VERMONT  
  
 CIVIL ENGINEERING ASSOCIATES, INC.  
 SHELBURNE, VERMONT  
**C-15A**