


BAY ROAD SEWER PROFILE

1" = 4' VERTICAL
1" = 20' HORIZONTAL

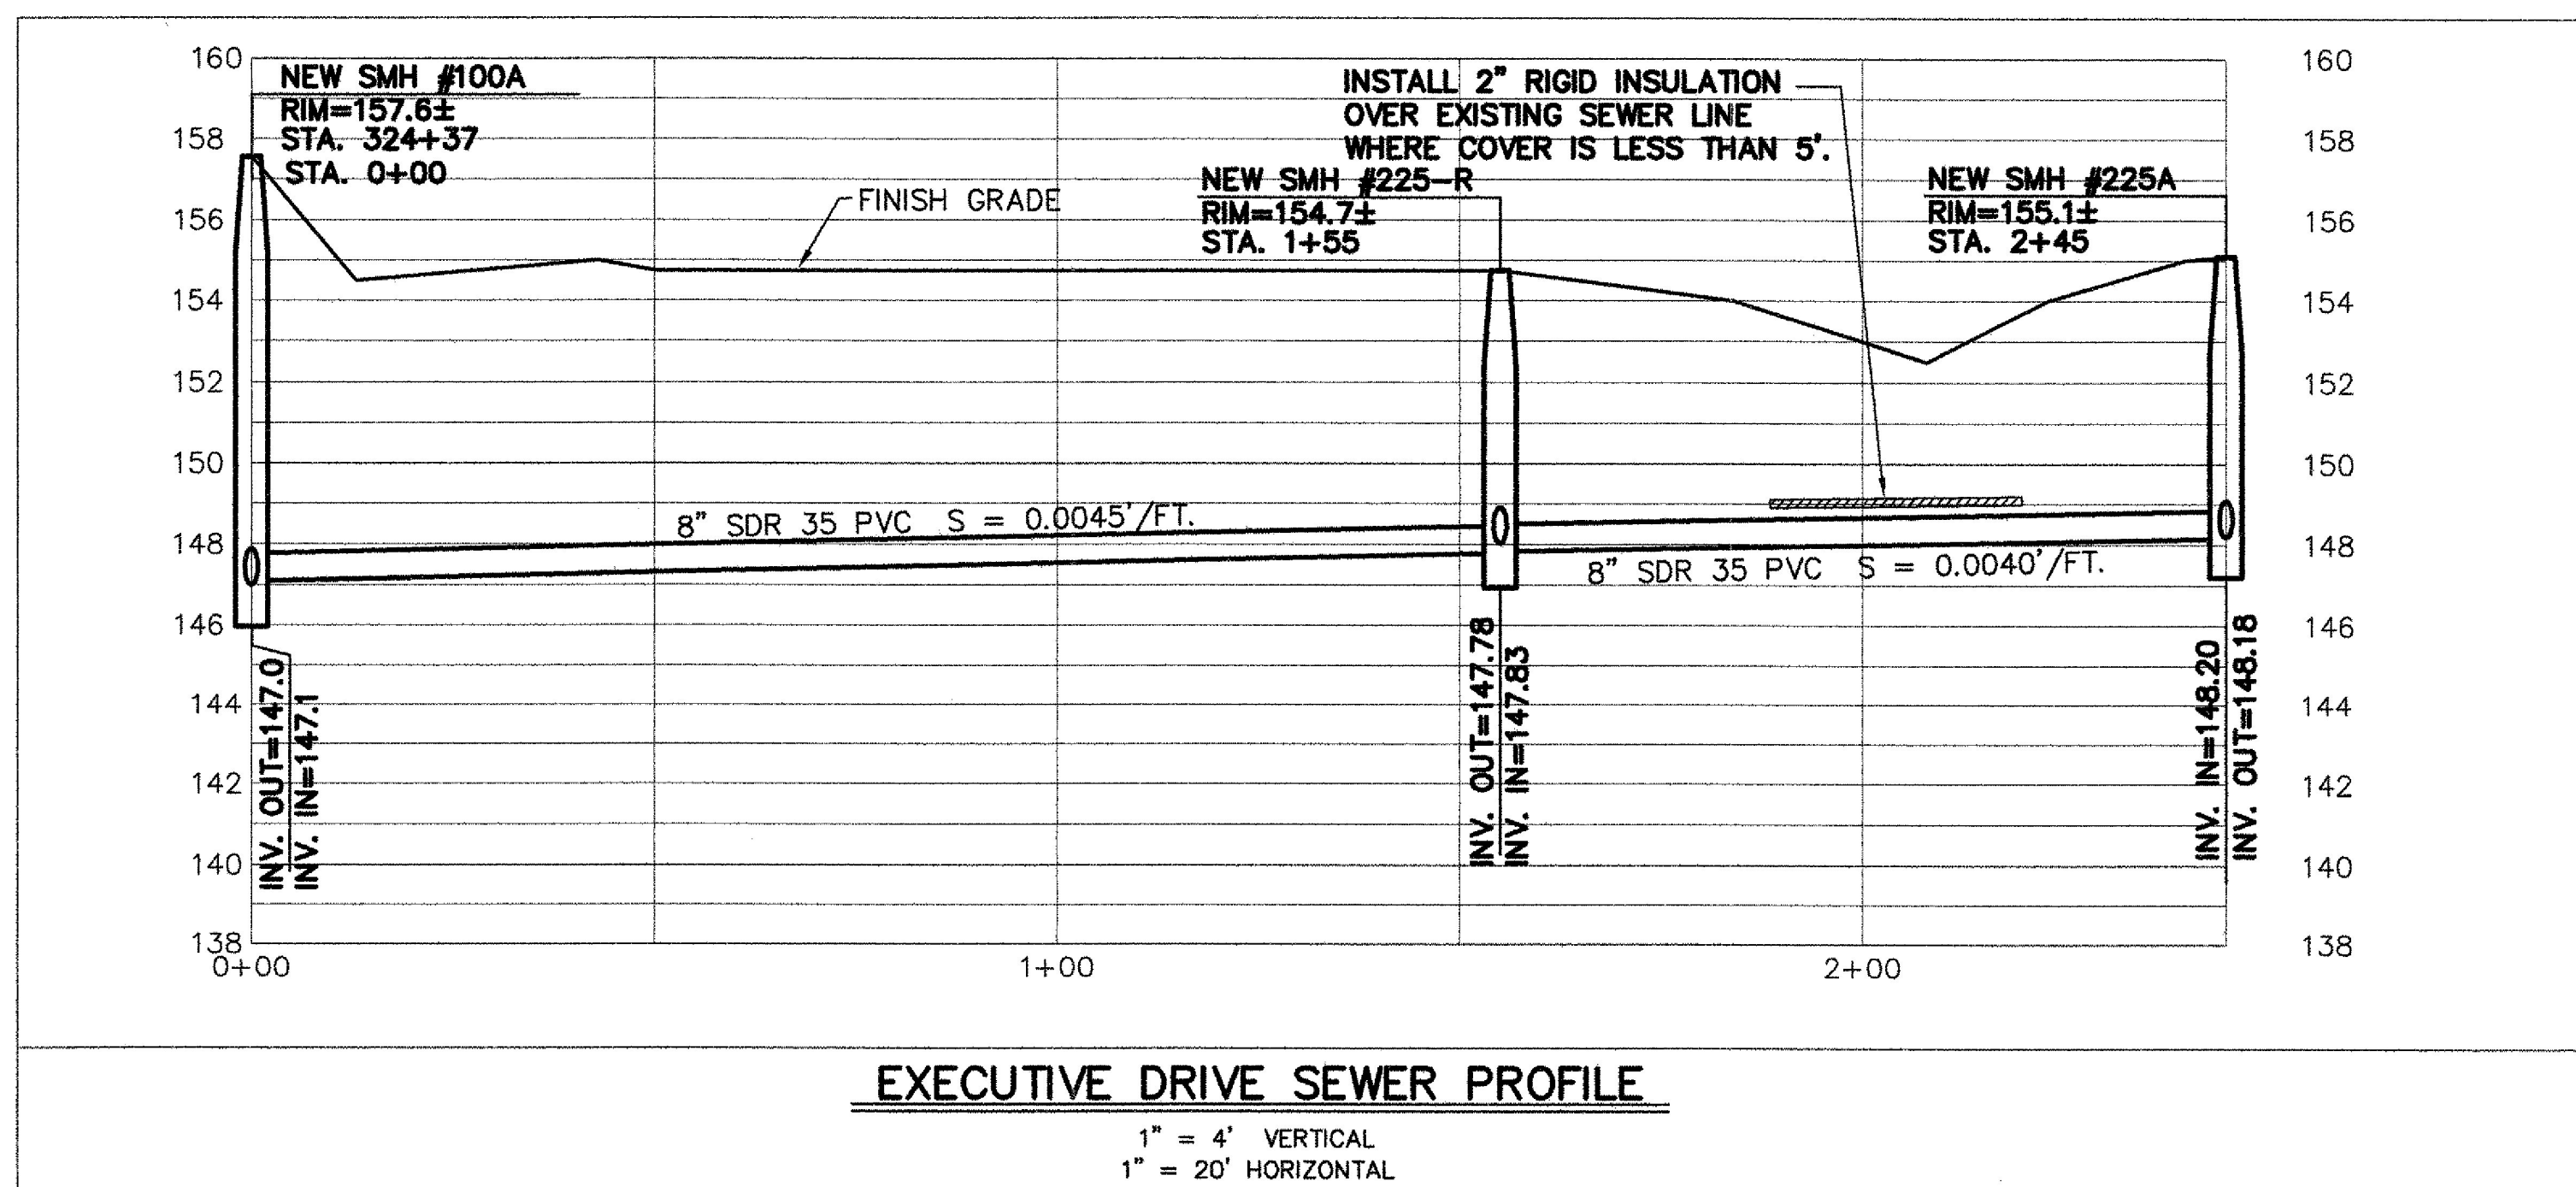

EXECUTIVE DRIVE SEWER PROFILE

1" = 4' VERTICAL
1" = 20' HORIZONTAL

Shelburne NH EGC 019-4 (27)
Sheet 479 of 537

RECORD DRAWING REVISIONS

NO	DATE	DESCRIPTION
1	11/10/09	FIELD MARK UPS ADDED TO THE PLANS



TOWN OF SHELBURNE SEWER/WATER RELOCATION (AOT WORK) BAY ROAD SEWER PROFILE			VERMONT
2-17-04	SAV/AOL	REVISED PROFILE	SHELBURNE
9-3-03	SAV/AOL	REVISED RIM ELEV. TO ±	
7-21-03	SAV/AOL	REVISED	
Date	Ch'kd	Revision	
Drawn by	ACL	Date	FEB., 2003
Checked by	SAV	Scale	1" = 20'
Approved by	SAV	Project No.	96111
CIVIL ENGINEERING ASSOCIATES, INC. SHELBURNE, VERMONT			C-15B

P:\AutoCAD Projects\1996\96111\ROUTE-7-SEWER.dwg, 02/17/2004 11:35:07 AM