


RECORD DRAWING REVISIONS

NO/DATE	DESCRIPTION
1, 11/10/09	FIELD MARK UPS ADDED TO THE PLANS

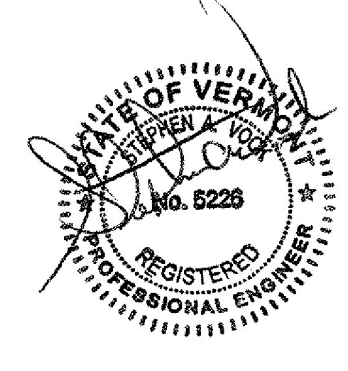

Date	Ch'k'd	Revision
1-5-04	SAV/AQL	REV'D WATER SYSTEM AS PER "AS BUILT" INFORMATION
10-21-03	SAV/AQL	REV'D SEWER & WATER AS PER AOT REVIEW COMMENTS
9-3-03	SAV/AQL	REVISED PER REVIEW COMMENTS
7-21-03	SAV/AQL	REVISED

Drawn by	ACL	Date	DEC., 2000
Checked by	SAV	Scale	AS NOTED
Approved by	SAV	Project No.	96111

TOWN OF SHELBURNE	
SEWER/WATER RELOCATION (AOT WORK)	
PLAN AND PROFILE	
STA. 351+00 TO 357+00	
SHELBURNE	VERMONT
CIVIL ENGINEERING ASSOCIATES, INC. SHELBURNE, VERMONT	SHEET C-20

P:\AutoCAD\Projects\1998\98111\ROUTE-7-SEWER.dwg, 01/07/2004, 12:54:09 PM