



WATER LINE DETAIL #12
 WATER PIPE AND SLEEVE @ 346+54 LT
 SEE SHEET 484 OF 537
 N.T.S

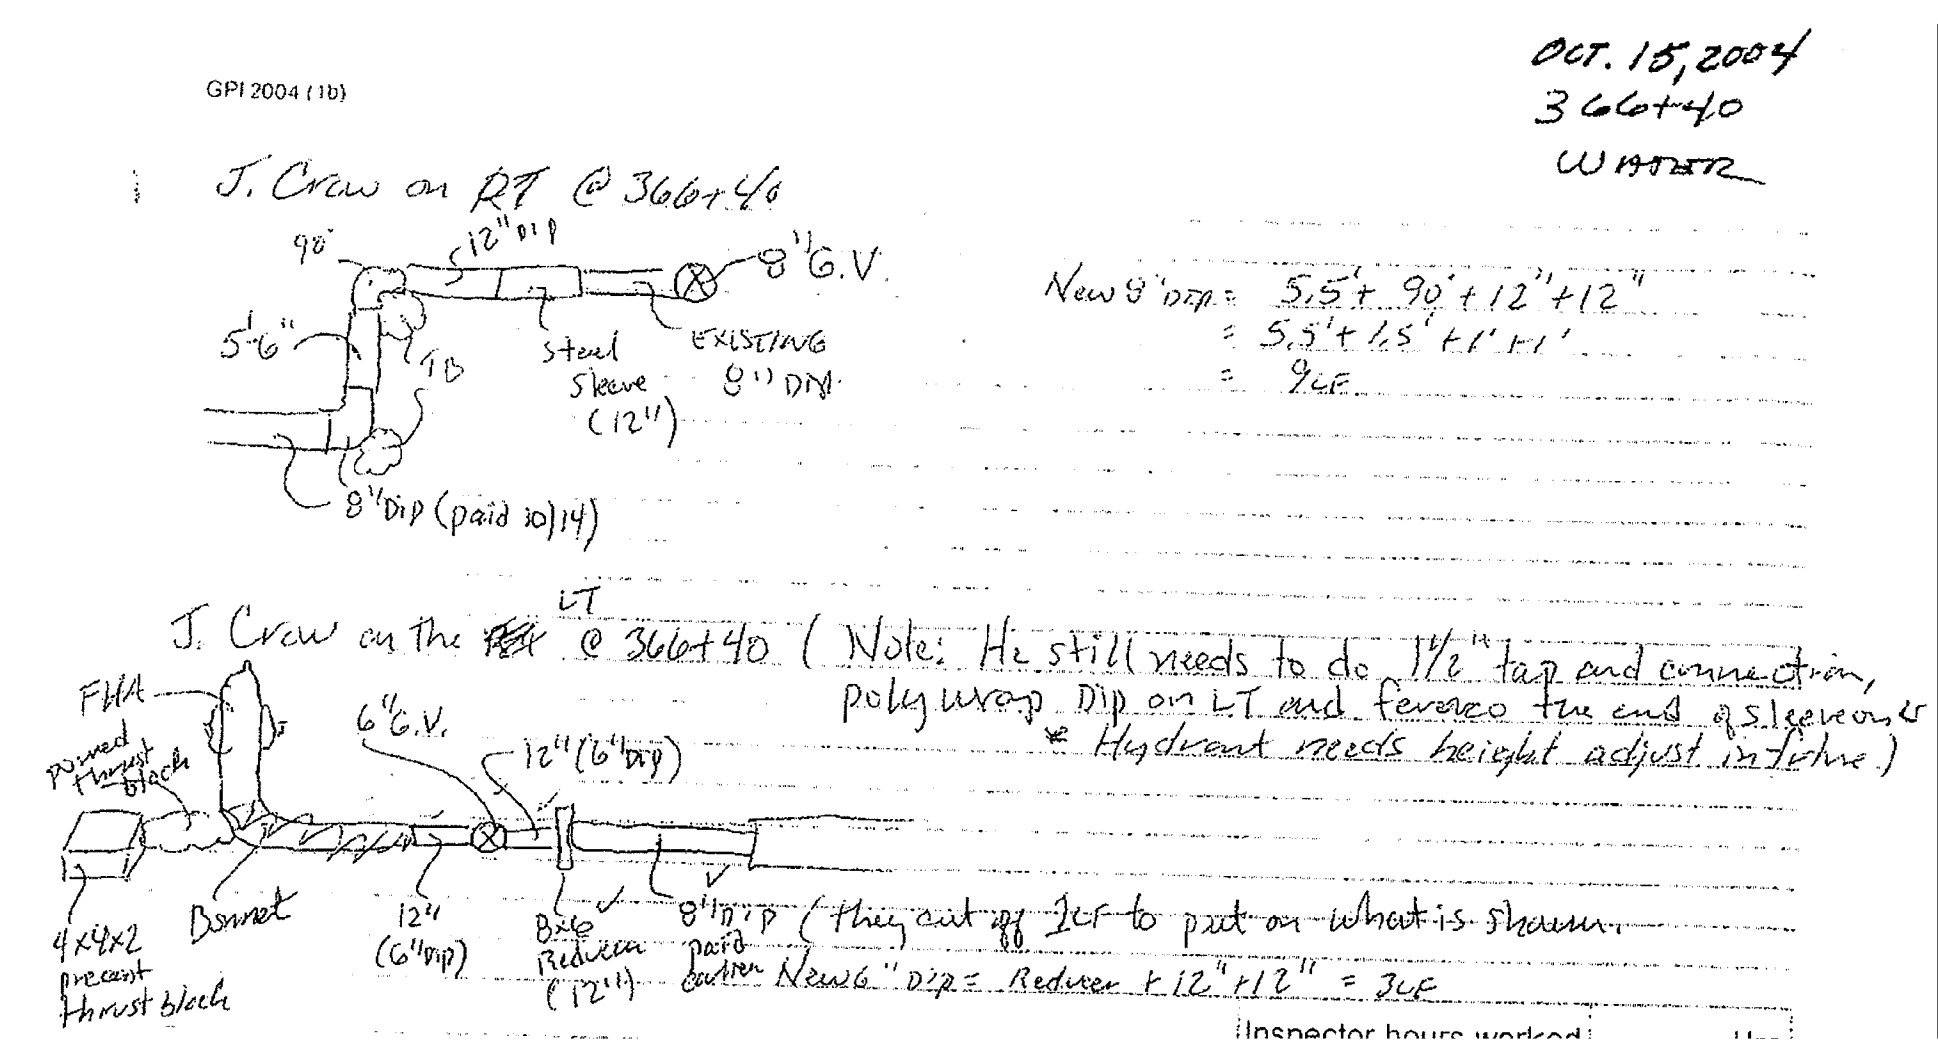

WATER LINE DETAIL #13
 WATER PIPE AND SLEEVE @ 366+40 RT-LT
 SEE SHEET 487 OF 537
 N.T.S

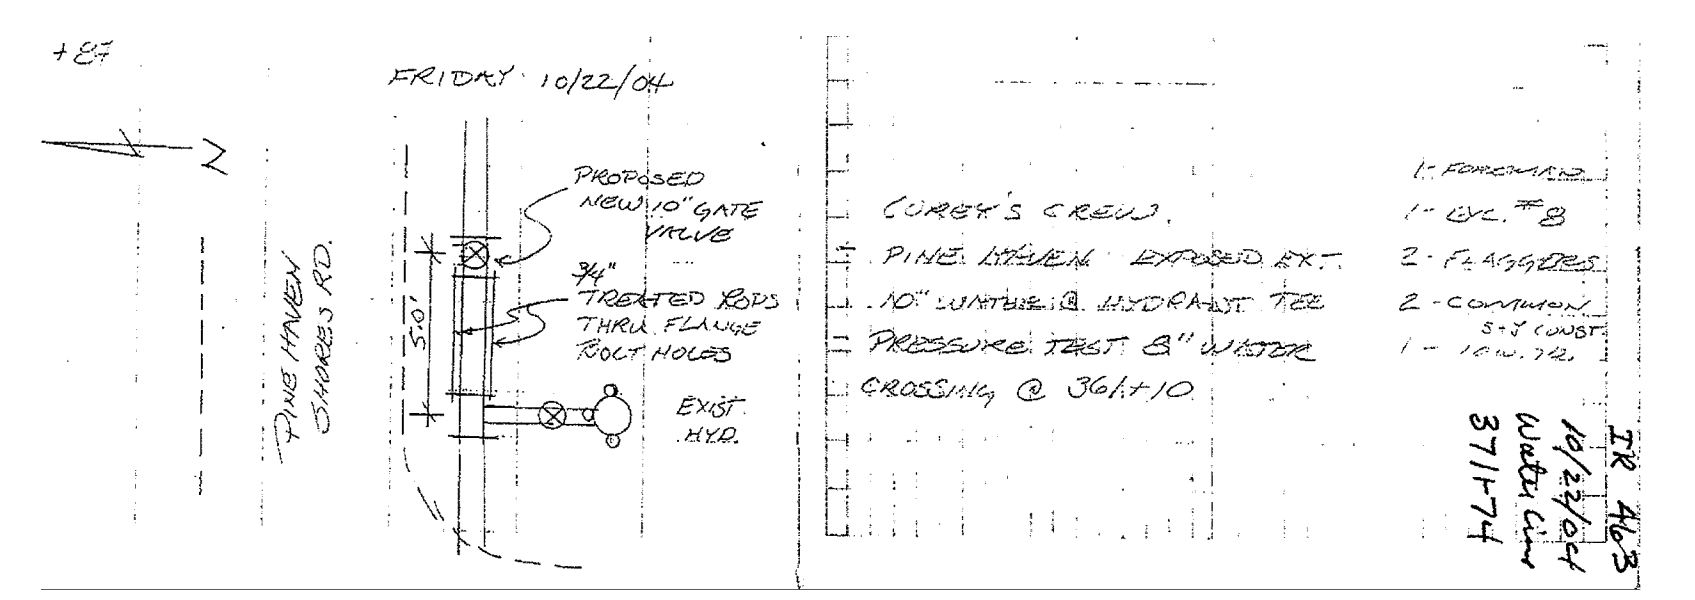

WATER LINE DETAIL #14
 WATER PIPE AND SLEEVE @ 371+74 LT
 SEE SHEET 488 OF 537
 N.T.S

PROJECT NAME:	SHELBURNE ROAD
PROJECT NUMBER:	NH-EGC-019-4(27)
FILE NAME:	
PROJECT LEADER:	
DESIGNED BY:	
FIELD SKETCH SHEET 3	
PLOT DATE:	11/12/2009
DRAWN BY:	STANTEC
CHECKED BY:	STANTEC
SHEET 494C	OF 537

