


MATCH TO PLAN DRAWING NO. 4, STA. 279+00

MATCH TO PLAN DRAWING NO. 6, STA. 285+00

MATCH TO PLAN DRAWING NO. 22

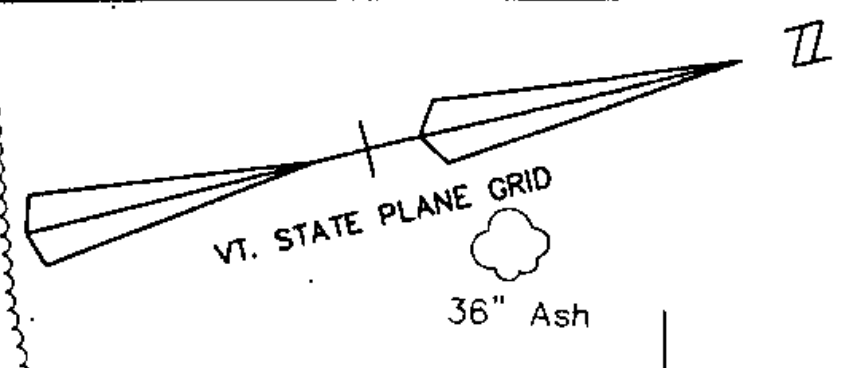

GREEN MOUNTAIN POWER CORPORATION SOUTH BURLINGTON, VERMONT			
12470Y 4W 3PH FEEDER			
<h2 style="margin: 0;">32G4 & 53G2</h2> <h3 style="margin: 0;">OVERHEAD</h3>			
SHELBURNE ROAD RECONSTRUCTION			
DRAWN: _____ DATE: _____	CHECKED: _____ DRAWING NO. GMP-08_3_05	APPROVED: _____ SHEET: 4	SCALE: 1"=20' SHEET: 4

Shelburne NH EGC 019-4 (27)
Sheet 498 of 537