


MATCH TO PLAN DRAWING NO. 10, STA. 315+00

MATCH TO PLAN DRAWING NO. 12, STA. 321+00

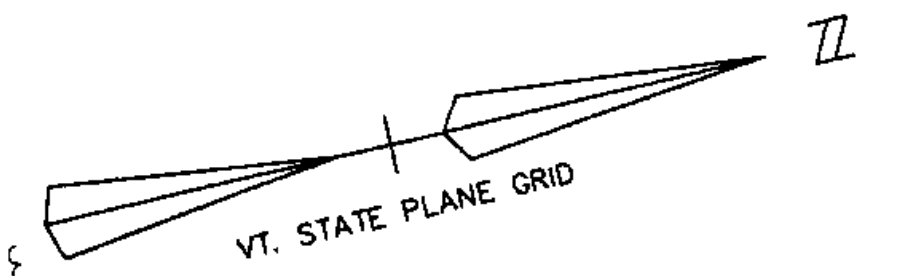

STA. 319+30.00  
 EXISTING 12'-0" X 10'-0" REINFORCED  
 CONCRETE BOX  
 CONSTRUCTED 1949.  $\Delta = 60'00''$  LT. &  $30'-0''$  RT.)

GREEN MOUNTAIN POWER CORPORATION SOUTH BURLINGTON, VERMONT			
12470Y 4W 3PH FEEDER			
<h2>32G4 &amp; 53G2</h2> <h3>OVERHEAD</h3>			
SHELburne ROAD RECONSTRUCTION			
DRAWN:	CHECKED:	APPROVED:	SCALE: 1"=20'
DATE:	DRAWING NO. GMP-14_3_11	SHEET: 10	

Shelburne NH EGC 019-4 (27)  
 Sheet 504 of 537