

646.415 DURABLE 150 mm YELLOW LINE
 STA. 0+380.000 - STA. I+600.000 SOLID LINE 3.6 m RT

646.615 TEMPORARY 150 mm YELLOW LINE
 STA. 0+380.000 - STA. I+600.000 SOLID LINE 3.6 m RT


646.414 DURABLE 150 mm WHITE LINE
 S=SOLID, D=DASHED

STA. 0+380.000 - STA. I+600.000 LT
 STA. 0+380.000 - STA. I+600.000 SOLID LINE 3.6 m LT

646.614 TEMPORARY 150 mm WHITE LINE
 S=SOLID, D=DASHED

STA. 0+380.000 - STA. I+600.000 LT
 STA. 0+380.000 - STA. I+600.000 SOLID LINE 3.6 m LT

675.50 REMOVING SIGNS
 AS SHOWN - 15

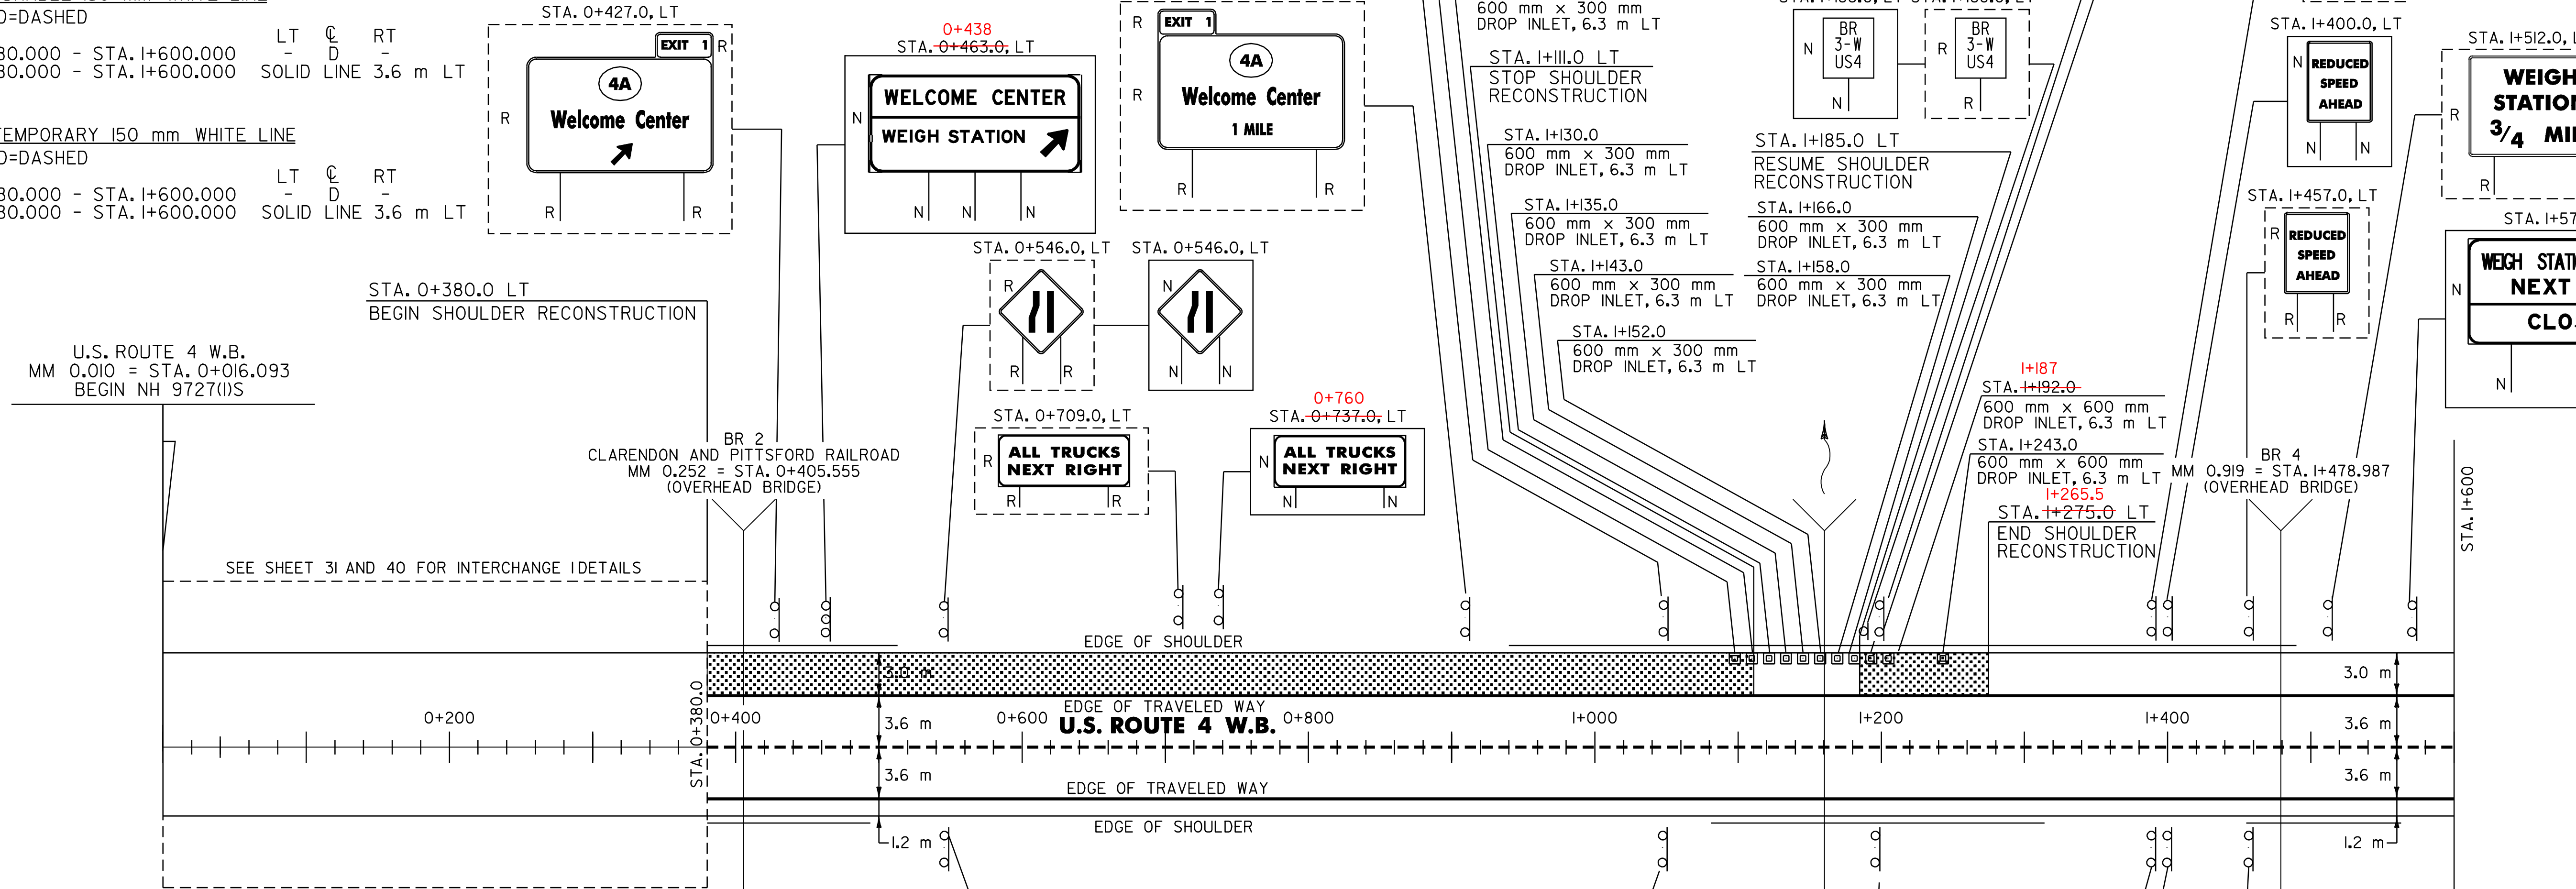

CHANGING ELEVATION OF DI'S, CB'S OR MH'S
 REHABING DI'S, CB'S OR MH'S
 SEE NOTE 4, SHEET 3 OF I19

~~STA. I+105.0 LT~~
~~STA. I+123.0 LT~~
~~STA. I+130.0 LT~~
~~STA. I+135.0 LT~~
~~STA. I+143.0 LT~~
~~STA. I+152.0 LT~~
~~STA. I+158.0 LT~~
~~STA. I+166.0 LT~~
~~STA. I+174.0 LT~~
~~STA. I+192.0 LT~~
~~STA. I+243.0 LT~~

DID NOT CHANGE ELEVATIONS ON BRIDGE DECK (10 EACH)

621.60 ANCHOR FOR STEEL BEAM RAIL
 STA. 0+949.2 LT 927.7
 STA. 0+672.1 LT

621.74 ALUMINUM APPROACH RAILING
 STA. I+097.4 - STA. I+105.0 LT (7.6 m)
 092.3 099.9

616.35 TREATED TIMBER CURB
 STA. I+035.0 - STA. I+105.0 LT (70.0 m)
 069.0 099.0

621.20 STEEL BEAM GUARDRAIL
 STA. 0+948.6 - STA. I+097.4 LT (148.8 m)
 0+932.1 I+092.3

621.54 MODIFIED ECCENTRIC LOADER TERMINAL
 STA. I+555.4 - STA. I+566.8 RT
 I+542.6 I+554.0

621.75 REMOVING AND RESET GUARDRAIL
 STA. I+454.0 - STA. I+555.4 RT (11.4 m)

621.76 REPLACE GUARDRAIL POST ASSEMBLY
 STA. I+454.0 - STA. I+555.4 RT (9 EA)

621.77 REPLACE GUARDRAIL BEAM UNIT
 STA. I+454.0 - STA. I+555.4 RT (3 EA)
 STA. 0+400 LT (3 EA)

621.80 REMOVAL AND DISPOSAL OF GUARDRAIL
 0+934 STA. 0+949.0 - STA. I+105.0 LT (156.0 m) I+099 (165 m)
 STA. I+555.4 - STA. I+563.0 RT (7.6 m)

DATUM	
VERTICAL	N/A
HORIZONTAL	N/A

SIGN LEGEND
 R= REMOVE
 S= SALVAGE
 N= NEW
 RET= RETAIN
 B-B= BACK TO BACK
 EXISTING= - - - - -
 NEW= _____

PAVING PROJECT LAYOUT

SURVEYED BY	N/A	DATE	N/A
DRAWN BY	J.N.	DATE	8/98
SQUAD LEADER	T.P.K.		
DESIGN FILE NO.	/pave/96bl54/pbl54.dgn		
IPARM FILE	pbl54.i	DATE PLOTTED	N/A
PROJ. NAME	FAIR HAVEN - RUTLAND		
PROJ. NO.	NH 9727(IIS)		
SHEET	12 OF I19	SHEETS	